

PANOLA  
D 20  
8-15-73

MISSISSIPPI  
BOARD OF WATER COMMISSIONERS  
416 North State Street  
Jackson, Mississippi 39201

CODED

WATER WELL DRILLERS LOG

8-15 1973 Panola Panola  
date well completed firm name county well located

LANDOWNER: 5 miles East  
of Comd Miss  
on Route 1 - Box 33  
(mailing address)

description of formations encountered	from	to
<u>sd</u>	<u>0</u>	<u>62</u>
<u>clay &amp; sand</u>	<u>62</u>	<u>142</u>
<u>sand</u>	<u>142</u>	<u>162</u>

WELL LOCATION:  
sec 33 T 6 N R 6 E  
5 miles East of Comd  
(distance) (direction) (nearest town)

WELL PURPOSE:  
(home, irrigation, municipal, industrial)

CODED

WELL COMPLETION DATA: 8-15-73

- (1) diameter (inches) 2
- (2) total depth (feet) 162 F
- (3) static water level (feet) 140 below top of ground.
- (4) casing sd 152  
(material) (depth)  
2 in if telescope see back.  
(size)
- (5) screen 4 FT 162 FT  
(length) (depth to top)
- (6) pump 1 crack 6 L.S.  
(HP) (yield gpm)  
250h  
(material) metal  
(type-power)
- (7) electric log no  
(yes or no)
- (organization running log)
- (8) how well bottom plugged


SEP 21 1973

DRILLERS REMARKS:

MISSISSIPPI  
BOARD OF WATER COMMISSIONERS  
JACKSON, MISSISSIPPI

If well telescopes please sketch and show depths.

GROUND LEVEL

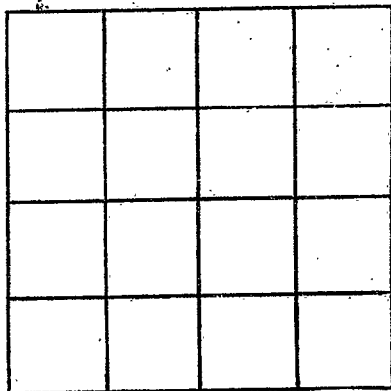

SECTION \_\_\_\_\_

Please indicate well location X.

ADDITIONAL INFORMATION

If more than one screen, show locations of each on sketch.