

Panda
D 21
4-13-74

MISSISSIPPI
 BOARD OF WATER COMMISSIONERS
 416 North State Street
 Jackson, Mississippi 39201

COPIED

WATER WELL DRILLERS LOG

APRIL 13 1974 *J. LEON WHITE* *PANDA LA*
 date well completed firm name county well located

LANDOWNER:
W. S. TAYLOR
POMO, Miss.
 (mailing address)

description of formations encountered	from	to
TOP SOIL	0	30
SANDY CLAY	30	75
COARSE WHITE SAND	75	145

WELL LOCATION:
 sec. *34* T. *6* N. R. *6* E.
7 miles *N-E* of *POMO*
 (distance) (direction) (nearest town)

WELL PURPOSE: *FARM*
 (home, irrigation, municipal, industrial)

WELL COMPLETION DATA:

(1) diameter (inches) *4"*

(2) total depth (feet) *145'*

(3) static water level (feet) *84'* ^{below} top of ground.

(4) casing *PLASTIC*, *145'*,
 (material) (depth)
4" If telescope see back.
 (size) *13*

(5) screen *13* ft. *145'*
 (length) (depth to top)
4", *PLASTIC GR. PACK.*
 (size) (material)

(6) pump *1* *20*
 (HP) (yield gpm)
ELC.
 (type power)

(7) electric log *NO.*
 (yes or no)
 (organization running log)

(8) how well bottom plugged *STRAINER*


COPIED

DRILLERS REMARKS:

RECORDED
 MAY 16 1974

If well telescopes please sketch and show depths.

GROUND LEVEL

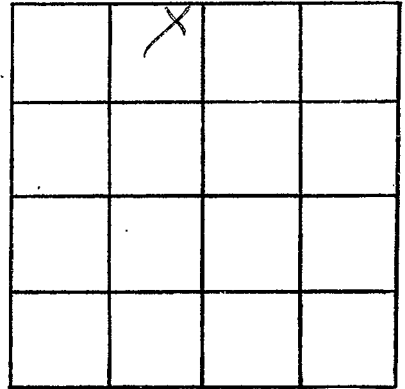

SECTION _____

Please indicate well location X.

ADDITIONAL INFORMATION

If more than one screen,
show locations of each on sketch.