

PANOLA
D22
4-25-75

MISSISSIPPI
BOARD OF WATER COMMISSIONERS
416 North State Street
Jackson, Mississippi 39201

By *John Shearer*
WATER WELL DRILLERS LOG

CODED
Panola

4-25-75 date well completed J B Cain firm name Panola county well located

LANDOWNER	description of formations encountered	from	to
<i>Mrs. M. Fred Ward</i>			
<i>Como Mo</i>	<i>Clay</i>	<i>0</i>	<i>15</i>
(mailing address)	<i>Sand</i>	<i>15</i>	<i>160</i>

WELL LOCATION:
sec. *29* T. *6* N. R. *6* E.
9 miles *N-E* of *Como*
(distance) (direction) (nearest town)

<i>Wash Sand</i>	<i>160</i>	<i>170</i>
------------------	------------	------------

WELL PURPOSE: *Home*
(home, irrigation, municipal, industrial)

WELL COMPLETION DATA:

(1) diameter (inches) *4"*

(2) total depth (feet) *170*

(3) static water level (feet) *140* below top of ground

(4) casing *Plastic*, *175* (material) (depth)

_____ if telescope see back.
(size)

(5) screen *10'*, *160* (length) (depth to top)
4" *Plastic* (size) (material)

(6) pump *3/4*, *10* (HP) (yield gpm)
Elect (type power)

(7) electric log *NO* (yes or no)

_____ (organization running log)

(8) how well bottom plugged *Wash Bottom*

CODED


INDEXED
RECORDED
APR 29 1975

MISS. BD. OF WATER COMMISSIONERS

DRILLERS REMARKS:
Rough Hole
grabbin sand

If well telescopes please sketch and show depths.

GROUND LEVEL

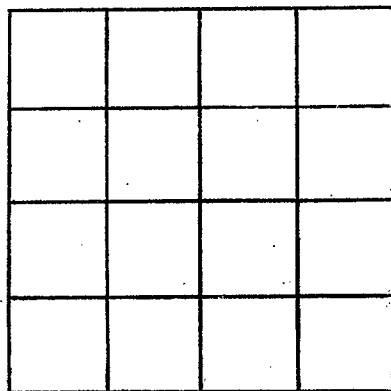

SECTION _____

Please indicate well location X.

ADDITIONAL INFORMATION

If more than one screen, show locations of each on sketch.