

Panola
D 23
4-21-75

MISSISSIPPI
 BOARD OF WATER COMMISSIONERS
 416 North State Street
 Jackson, Mississippi 39201

CODED

WATER WELL DRILLERS LOG

April 21, 1975 Bob Smith Vee Drilling Panola
 date well completed firm name county well located

LANDOWNER: <u>Frank Beefe</u>	description of formations encountered	from	to
<u>Rt. 3 Box 42A</u> <u>Como, Miss.</u> (mailing address)			
WELL LOCATION: sec. <u>21</u> T. <u>6</u> N. R. <u>6</u> E <u>8</u> miles <u>E</u> of <u>Como</u> (distance) (direction) (nearest town)	<u>top soil</u>	<u>0'</u>	<u>10'</u>
WELL PURPOSE: <u>Home</u> (home irrigation, municipal, industrial)	<u>White sand</u>	<u>10'</u>	<u>50'</u>
WELL COMPLETION DATA: (1) diameter (inches) <u>4"</u>	<u>White Clay & sand</u>	<u>50'</u>	<u>100'</u>
(2) total depth (feet) <u>210'</u>	<u>Black clay & sand</u>	<u>100'</u>	<u>160'</u>
(3) static water level (feet) <u>65'</u> below top of ground.	<u>White sand</u>	<u>160'</u>	<u>210'</u>
(4) casing <u>plastic</u> , <u>210'</u> (material) (depth)			
(size) if telescope see back.			
(5) screen <u>10'</u> , <u>200'</u> (length) (depth to top)			
<u>4"</u> , <u>plastic</u> (size) (material)			
(6) pump <u>1/2</u> , <u>10</u> (HP) (yield gpm)			
<u>electric</u> (type power)			
(7) electric log <u>no</u> (yes or no)			
(organization running log)			
(8) how well bottom plugged <u>plugged</u>			
DRILLERS REMARKS:			

CODE


RECEIVED
 APR 21 1975

APR 4 1975

MISS. BD. OF WATER COMM

If well telescopes please sketch and show depths.

GROUND LEVEL

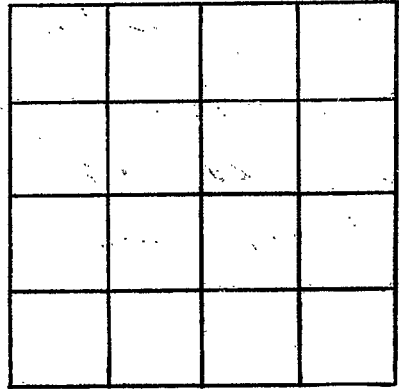

SECTION _____

Please indicate well location X.

ADDITIONAL INFORMATION

If more than one screen, show locations of each on sketch.