

Panola  
D 2000  
12-4-75

MISSISSIPPI  
 BOARD OF WATER COMMISSIONERS  
 416 North State Street  
 Jackson, Mississippi 39201

WATER WELL DRILLERS LOG

R-4 75<sup>15E</sup> HICKS Well Co. Panola  
 date well completed firm name county well located

LANDOWNER: Professor Wilbur N. COMO  
MISS  
 (mailing address)

WELL LOCATION:  
 sec. 35 T-6 N R-6 E  
8 miles EAST of COMO  
 (distance) (direction) (nearest town)

WELL PURPOSE:  
 (home, irrigation, municipal, industrial)

WELL COMPLETION DATA:

(1) diameter (inches) 11"

(2) total depth (feet) 245

(3) static water level (feet) 130 below above top of ground.

(4) casing P.V.C. 245  
 (material) (depth)

\_\_\_\_\_ if telescope see back.  
 (size)

(5) screen 7ft 7ft  
 (length) (depth to top)

1/4" invisle Sand  
 (size) (material)

(6) pump 3/4 10  
 (HP) (yield gpm)

E.P. 220  
 (type power)

(7) electric log \_\_\_\_\_  
 (yes or no)

\_\_\_\_\_ (organization running log)

(8) how well bottom plugged Caps


Description of formations encountered	from	to
Red Clay	0	10
W.C.	10	20
White Sand	20	135
Rock	135	136
Black Clay & Sand	136	213
Rock	213	214
White Sand	214	245

DRILLERS REMARKS:

DEC 22 1975

If well telescopes please sketch and show depths.

GROUND LEVEL

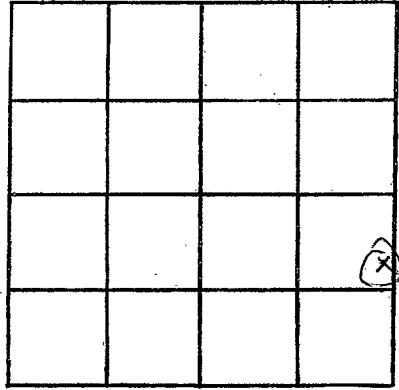

SECTION \_\_\_\_\_

Please indicate well location X.

ADDITIONAL INFORMATION

If more than one screen, show locations of each on sketch.