

PANOLA
D 2001
2-19-76

MISSISSIPPI
 BOARD OF WATER COMMISSIONERS
 416 North State Street
 Jackson, Mississippi 39201

WATER WELL DRILLERS LOG

2-19 1976 Hicks well co. PANOLA
 date well completed firm name county well located


LANDOWNER: <u>ANNIE M. NORTON</u>	description of formations encountered	from	to
<u>PT-1 COMO</u>	<u>Red CLAY</u>	<u>0</u>	<u>30</u>
	<u>Red SAND & CLAY</u>	<u>30</u>	<u>165</u>
	<u>White SAND</u>	<u>165</u>	<u>210</u>

(mailing address)

WELL LOCATION:
 sec 21 T 6 N R 5 E
 S W
1.5 miles E of COMO
 (distance) (direction) (nearest town)

WELL PURPOSE: Home
 (home, irrigation, municipal, industrial)

- WELL COMPLETION DATA:
- (1) diameter (inches) 4"
 - (2) total depth (feet) 210
 - (3) static water level (feet) 150 below above top of ground.
 - (4) casing PVC, 203,
 (material) (depth)
 (size) If telescope see back.
 - (5) screen 7' 7'
 (length) (depth to top)
 - (6) pump 3/4 10
 (HP) (yield gpm)
EIC
 (type power)
 - (7) electric log NO
 (yes or no)
 (organization running log)
 - (8) how well bottom plugged CAP

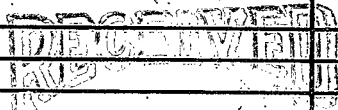

APR 27 1976

DRILLERS REMARKS:

