

Panola
D 2003
11-16-76

MISSISSIPPI
 BOARD OF WATER COMMISSIONERS
 416 North State Street
 Jackson, Mississippi 39201

WATER WELL DRILLERS LOG

11-16 1976 Heath Well Co. Panola
 date well completed firm name county well located

LANDOWNER: Hunter Chapel

Rt. 1
Como, Ms.
 (mailing address)

description of formations encountered	from	to
	<u>Red Clay</u>	<u>0</u>
<u>Sand + gravel</u>	<u>30</u>	<u>90</u>
<u>White Sand</u>	<u>90</u>	<u>138</u>

WELL LOCATION:
 sec. 30 T. 6 N. R. 6 E
2 miles NE of Como
 (distance) (direction) (nearest town)

WELL PURPOSE: Church
 (home, irrigation, municipal, industrial)

- WELL COMPLETION DATA:
- (1) diameter (inches) 4
 - (2) total depth (feet) 138
 - (3) static water level (feet) 65 below above top of ground.
 - (4) casing PVC 138
 (material) (depth)
 - _____ If telescope see back.
 (size)
 - (5) screen 4' 134'
 (length) (depth to top)
 - 4" Gravel type
 (size) (material)
 - (6) pump 1/2 10
 (HP) (yield gpm)
 - 220V
 (type power)
 - (7) electric log No
 (yes or no)
 - _____ (organization running log)
 - (8) how well bottom plugged Cap


DRILLERS REMARKS:

RECEIVED
 JAN 5 1977

MISSISSIPPI BOARD OF WATER COMMISSIONERS

If well telescopes please sketch and show depths.

GROUND LEVEL

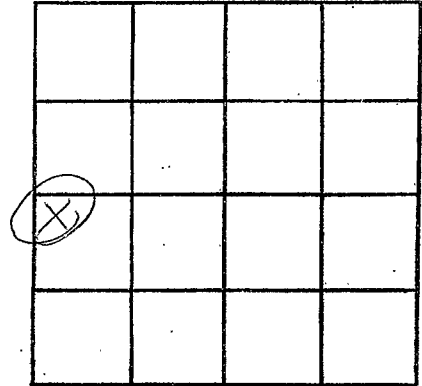

SECTION 30

Please indicate well location X.

ADDITIONAL INFORMATION

If more than one screen,
show locations of each on sketch.