

PANOLA
D 2004
2-9-77

MISSISSIPPI
 BOARD OF WATER COMMISSIONERS
 416 North State Street
 Jackson, Mississippi 39201

WATER WELL DRILLERS LOG

2-9 1977 Dicks Well Co Panola
 date well completed firm name county well located

LANDOWNER: James Clark

description of formations encountered	from	to
	<u>Red Clay</u>	<u>0</u>
<u>Red Sand + clay</u>	<u>20</u>	<u>60</u>
<u>White Sand + Clay</u>	<u>60</u>	<u>120</u>
<u>White Sand</u>	<u>120</u>	<u>200</u>

Senatobia, Ms. 38668
 (mailing address)

WELL LOCATION:
 sec. 29 T. 6 N. R. 5 E
13 miles SE of Como
 (distance) (direction) (nearest town)

WELL PURPOSE: Home
 (home, irrigation, municipal, industrial)


- WELL COMPLETION DATA:
- (1) diameter (inches) 4
 - (2) total depth (feet) 200
 - (3) static water level (feet) 155 below above top of ground.
 - (4) casing PVC 155
 (material) (depth)
 - (size) If telescope see back.
 - (5) screen 7/8 193
 (length) (depth to top)
 - 4" Gravel type
 (size) (material)
 - (6) pump 3/4 10
 (HP) (yield gpm)
 - 220V
 (type power)
 - (7) electric log No
 (yes or no)
 - (organization running log)
 - (8) how well bottom plugged Cap

DRILLERS REMARKS:

RECEIVED
 FEB 24 1977
 MISS. BD. OF WATER COMMISSIONERS

If well telescopes please sketch and show depths.

GROUND LEVEL

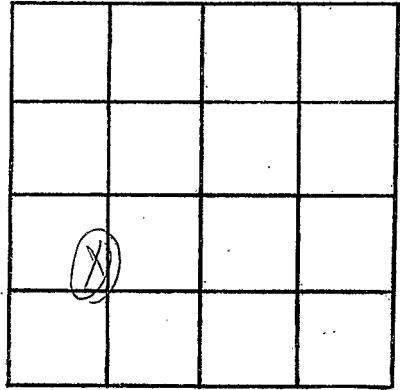

SECTION 29

Please indicate well location X:

ADDITIONAL INFORMATION

If more than one screen,
show locations of each on sketch.