

PANOLA
 D 2005
 2-21-77

MISSISSIPPI
 BOARD OF WATER COMMISSIONERS
 416 North State Street
 Jackson, Mississippi 39201

WATER WELL DRILLERS LOG

PANOLA
 Lafayette

date well completed: 2-21-1977
 firm name: Dick Well Co
 county well located: Lafayette

LANDOWNER: John Taylor
 Rt. 1
 Como, Mo.
 (mailing address)

description of formations encountered	depth	
	from	to
Red Clay	0	20
Red Sand	20	30
White Clay	30	80
White Sand	80	110

WELL LOCATION:
 sec. 33 T. 6 N. R. 5 E.
 2 miles NE of Jackboro
 (distance) (direction) (nearest town)

WELL PURPOSE: Home
 (home, irrigation, municipal, industrial)

- WELL COMPLETION DATA:
- (1) diameter (inches) 4
 - (2) total depth (feet) 110
 - (3) static water level (feet) 90 below above ground.
 - (4) casing PVC 110 (material) (depth)
 - (size) If telescope see back.
 - (5) screen 7ft 103 (length) (depth to top)
 - 4in. Traveler (size) (material)
 - (6) pump 1/2 10 (HP) (yield gpm)
 - 220V (type power)
 - (7) electric log No. (yes or no)
 - (organization running log)
 - (8) how well bottom plugged Cap


RECEIVED
 FEB 21 1977

DRILLERS REMARKS:

MISS. BD. OF WATER COMMISSIONERS

If well telescopes please sketch and show depths.

GROUND LEVEL

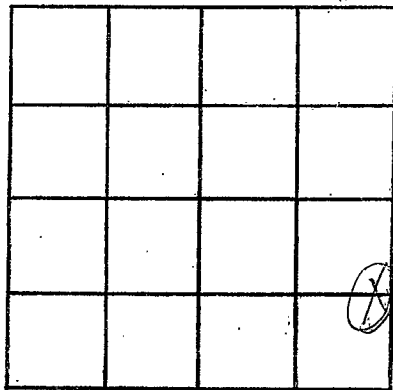

SECTION

33

Please indicate well location X.

ADDITIONAL INFORMATION

If more than one screen, show locations of each on sketch.