

PANOLA  
 D 2886  
 3-10-77

MISSISSIPPI  
 BOARD OF WATER COMMISSIONERS  
 416 North State Street  
 Jackson, Mississippi 39201

WATER WELL DRILLERS LOG

3-10-77 date well completed  
 15E Hicks Well Co. firm name  
 Panola county well located

LANDOWNER: Albe Hartley  
Rt. 1  
Como, MS.  
 (mailing address)

WELL LOCATION:  
 sec 25 T 6 N R 6 E  
14 miles E of Como  
 (distance) (direction) (nearest town)

WELL PURPOSE: same  
 (home, irrigation, municipal, industrial)

WELL COMPLETION DATA:  
 (1) diameter (inches) 4  
 (2) total depth (feet) 160  
 (3) static water level (feet) 150 below above top of ground.  
 (4) casing PVC 160  
 (material) (depth)  
 (size) if telescope see back.  
 (5) screen 7' 153'  
 (length) (depth to top)  
4" Gravel type  
 (size) (material)  
 (6) pump 3/4 10  
 (HP) (yield gpm)  
220V  
 (type power)  
 (7) electric log NO  
 (yes or no)  
 (organization running log)  
 (8) how well bottom plugged Cap


description of formations encountered	from	to
Red Clay	0	15
Red Sand	15	45
White Clay	45	50
White Sand	50	55
White Clay	55	90
White Sand	90	95
White Sand + Clay	95	125
White Sand	125	160

RECEIVED  
 MAY 1 1977

DRILLERS REMARKS:

If well telescopes please sketch and show depths.

GROUND LEVEL

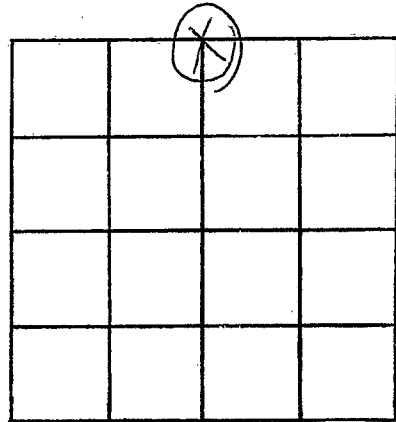

SECTION 26

Please indicate well location X.

ADDITIONAL INFORMATION

If more than one screen,  
show locations of each on sketch.