

PANOLA  
D 2007  
5-25-77

MISSISSIPPI  
BOARD OF WATER COMMISSIONERS  
416 North State Street  
Jackson, Mississippi 39201

WATER WELL DRILLERS LOG

5-25 1977 Harris Bros. Panola  
date well completed firm name county well located

LANDOWNER: J.P. Stone  
P.O. Box B  
Como  
(mailing address)

WELL LOCATION:  
sec 33 T 6 N R 6 E  
6 miles E of Como  
(distance) (direction) (nearest town)

WELL PURPOSE: home  
(home, irrigation, municipal, industrial)

WELL COMPLETION DATA:

(1) diameter (inches) 4  
(2) total depth (feet) 180  
(3) static water level (feet) 120 below top of ground.  
(4) casing Plastic 166 (material) (depth)  
4 (size) If telescope see back.  
(5) screen 14' (length) 166' (depth to top)  
008 (size) Plastic (material)  
(6) pump 3/4 (HP) 10 (yield gpm)  
elec. (type power)  
(7) electric log No (yes or no)  
(organization running log)  
(8) how well bottom plugged solid

description of formations encountered	from	to
top soil	0	20
clay + fine sand	20	80
fine sand	80	130
Coarse sand	130	180


DRILLERS REMARKS:

RECEIVED  
SEP 30 1977

MISS. BD. OF WATER COMMISSIONERS

If well telescopes please sketch and show depths.

GROUND LEVEL

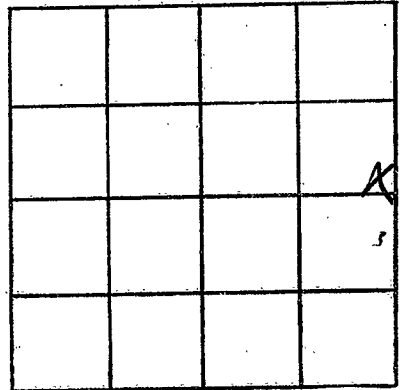

SECTION 33

Please indicate well location X.

ADDITIONAL INFORMATION

If more than one screen,  
show locations of each on sketch.