

PANOLA
D 2008
6-24-77

MISSISSIPPI
BOARD OF WATER COMMISSIONERS
416 North State Street
Jackson, Mississippi 39201

WATER WELL DRILLERS LOG

6-24-77 date well completed
Nick Wells Co. firm name
Panola county well located

LANDOWNER: Ben Mae Miller
(Pt.)
Cone, Mo
(mailing address)

description of formations encountered	from	to
Red clay	0	40
Red sand	40	95
White sand	95	140

WELL LOCATION:
sec. 24 T. 6 N. R. 6 E.
9 1/2 miles E of Cone
(distance) (direction) (nearest town)

WELL PURPOSE: Home
(home, irrigation, municipal, industrial)

WELL COMPLETION DATA:

(1) diameter (inches) 4

(2) total depth (feet) 140

(3) static water level (feet) 100 below top of ground.

(4) casing PVC, 140 (material) (depth)
(size) if telescope see back.

(5) screen 7, 133 (length) (depth to top)
4" gravel type (size) (material)

(6) pump 1/2, 10 (HP) (yield gpm)
2200 (type power)

(7) electric log No (yes or no)

(organization running log)

(8) how well bottom plugged Cap

RECEIVED


UG 1 17 1977

DRILLERS REMARKS:

MISS. BD. OF WATER COMMISSIONERS

If well telescopes please sketch and show depths.

GROUND LEVEL

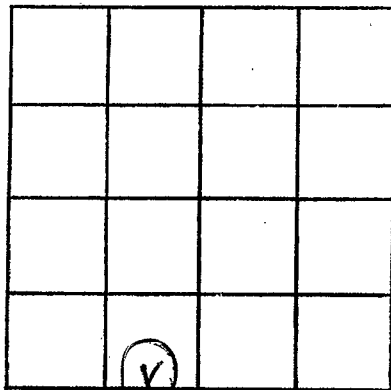

SECTION 24

Please indicate well location X.

ADDITIONAL INFORMATION

Lined area for additional information.

If more than one screen, show locations of each on sketch.