

PANOLA

D 2012

3-5-78

MISSISSIPPI  
BOARD OF WATER COMMISSIONERS  
416 North State Street  
Jackson, Mississippi 39201

WATER WELL DRILLERS LOG

3-5 1978 High Well Co. Panola  
date well completed firm name county well located

LANDOWNER: John Taylor

Rt. 1

Como, Ms.

(mailing address)

description of formations encountered

from

to

Red Clay

0 20

Red Sand

20 90

WELL LOCATION:

sec. 29 T 6 N R. 5 E  
(S) (W)

— miles — of Stennis  
 (distance) (direction) (nearest town)

White Clay Sand

90 40

White Sand

140 213

WELL PURPOSE: Home  
 (home, irrigation, municipal, industrial)

WELL COMPLETION DATA:

- (1) diameter (inches) 4
- (2) total depth (feet) 213
- (3) static water level (feet) 160 below  
top of ground.
- (4) casing PVC, 213,  
(material) (depth)  
if telescope see back.
- (5) screen 7', 206  
(length) (depth to top)  
4" PVC + Arrow  
(size) (material)
- (6) pump 3/4 10  
(HP) (yield gpm)  
220V  
(type power)
- (7) electric log No  
(yes or no)

(organization running log)

(8) how well bottom plugged Cap


DRILLERS REMARKS:

**RECEIVED**  
MAY 1 - 1978

MISS. BD. OF WATER COMM.

If well telescopes please sketch and show depths.

GROUND LEVEL

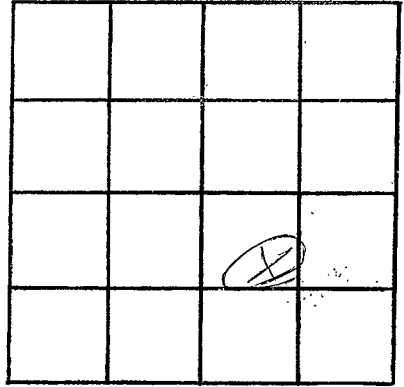

SECTION 29

Please indicate well location X.

ADDITIONAL INFORMATION

If more than one screen,  
show locations of each on sketch.