

PANOLA
 D. 2013
 [Signature]

MISSISSIPPI
 BOARD OF WATER COMMISSIONERS
 416 North State Street
 Jackson, Mississippi 39201

WATER WELL DRILLERS LOG

4-28-1978 date well completed
 78 Hick Well Co firm name
 Panola county well located

LANDOWNER: <u>John W. Nelson</u>	description of formations encountered	from	to
<u>Ret. 1,</u>	<u>Red Clay</u>	<u>0</u>	<u>20</u>
<u>Cone, Mo.</u> (mailing address)	<u>Sand + Clay</u>	<u>20</u>	<u>165</u>
WELL LOCATION: sec. <u>35</u> T. <u>6</u> N. R. <u>6</u> E.	<u>Rock</u>	<u>165</u>	<u>167</u>
<u>8</u> miles <u>E</u> of <u>Cone</u>	<u>Clay</u>	<u>167</u>	<u>230</u>
(distance) (direction) (nearest town)	<u>Rock</u>	<u>230</u>	<u>232</u>
WELL PURPOSE: <u>Home</u> (home, irrigation, municipal, industrial)	<u>White Sand</u>	<u>232</u>	<u>265</u>

WELL COMPLETION DATA:

(1) diameter (inches) 4

(2) total depth (feet) 265

(3) static water level (feet) 160 below top of ground.

(4) casing PVC, 265 (material), (depth)

(size) if telescope see back.

(5) screen 7', 258 (length), (depth to top)

4', gravel type (size), (material)

(6) pump 3/4, 10 (HP), (yield gpm)

2200 (type power)

(7) electric log Yes (yes or no)

(organization running log)

(8) how well bottom plugged Cap


RECEIVED
 MAY 30 1978

DRILLERS REMARKS:

MISS. BD. OF WATER COMM

If well telescopes please sketch and show depths.

GROUND LEVEL

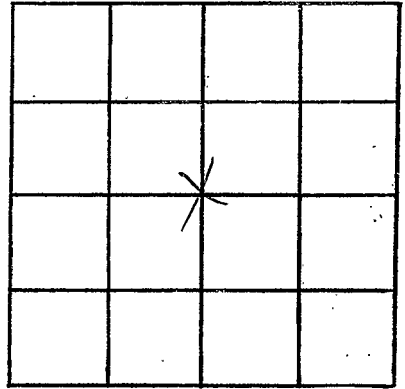

SECTION 35

Please indicate well location X.

ADDITIONAL INFORMATION

If more than one screen,
show locations of each on sketch.