


PANOLA  
 D 2016

MISSISSIPPI  
 BOARD OF WATER COMMISSIONERS  
 416 North State Street  
 Jackson, Mississippi 39201

WATER WELL DRILLERS LOG

6-30-19 78 High Well Co. Panola  
 date well completed firm name county well located

LANDOWNER	description of formations encountered	from	to
Nathaniel Dandridge Rt. 1	Red clay	0	18
Como, Miss. (mailing address)	Red sand	18	30
WELL LOCATION: sec. 36 6 N R. 6 E 7 miles E of Como (distance) (direction) (nearest town)	White clay	30	60
WELL PURPOSE: Home (home, irrigation, municipal, industrial)	White sand	60	120
WELL COMPLETION DATA: (1) diameter (inches) 4	White sand & clay	120	205
(2) total depth (feet) 230	White sand	205	230
(3) static water level (feet) _____ below above top of ground.			
(4) casing PVC 230 (material) (depth)			
_____ If telescope see back. (size)			
(5) screen 7 223 (length) (depth to top)			
4' gravel type (size) (material)			
(6) pump 3/4 18 (HP) (yield gpm)			
220V (type power)			
(7) electric log No (yes or no)			
_____ (organization running log)			
(8) how well bottom plugged Cap			
DRILLERS REMARKS:			

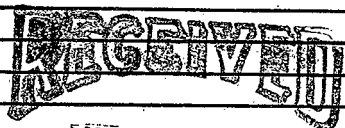


JUL 21 1978

MISS. BD. OF WATER COMM.

If well telescopes please sketch and show depths.

GROUND LEVEL

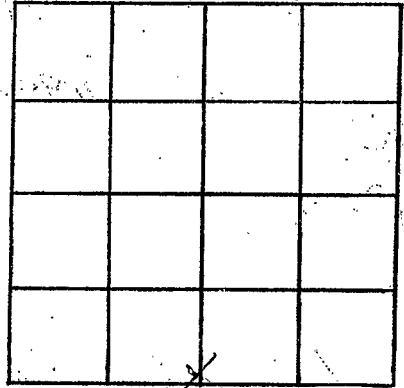

SECTION 36

Please indicate well location X.

ADDITIONAL INFORMATION

If more than one screen, show locations of each on sketch.