

PANOLA
 D 217

MISSISSIPPI
 BOARD OF WATER COMMISSIONERS
 416 North State Street
 Jackson, Mississippi 39201

WATER WELL DRILLERS LOG

PANOLA

7-1 1978 Hick Well Co. ~~Marshall~~
 date well completed firm name county well located

LANDOWNER	description of formations encountered	from	to
Mary Francis Moser	Red clay	0	30
Byhalia, Mo. (mailing address)	Red sand	30	45
WELL LOCATION: sec. 36 T 6 N R 6 E 7 miles E of Como (distance) (direction) (nearest town)	White sand & clay	45	125
	White sand	125	183
WELL PURPOSE: (home, irrigation, municipal, industrial)			
WELL COMPLETION DATA:			
(1) diameter (inches) 4			
(2) total depth (feet) 183			
(3) static water level (feet) 140 below top of ground.			
(4) casing PVC, 183 (material) (depth)			
(size) if telescope see back.			
(5) screen 7 (length), 176 (depth to top)			
4" (size), gran. type (material)			
(6) pump 3/4 (HP), 16 (yield gpm)			
220V (type power)			
(7) electric log No (yes or no)			
(organization running log)			
(8) how well bottom plugged Cap			
DRILLERS REMARKS:			


RECEIVED

JUL 21 1978

MISS. BD. OF WATER COMM

If well telescopes please sketch and show depths.

GROUND LEVEL

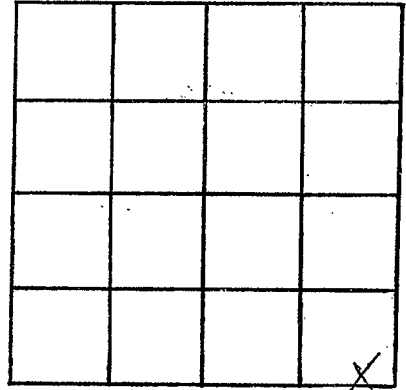

SECTION 17

Please indicate well location X.

ADDITIONAL INFORMATION

If more than one screen,
show locations of each on sketch.