

PANOLA
D 2018
11-1-78

**MISSISSIPPI
BOARD OF WATER COMMISSIONERS**
416 North State Street
Jackson, Mississippi 39201

WATER WELL DRILLERS LOG

11-1-1978 Hick Well Co. Panola
 date well completed firm name county well located


LANDOWNER:	description of formations encountered	from	to
Ret. 1			
Cone, Miss. (mailing address)	Red Clay	0	10
WELL LOCATION: sec. 26 T 6 N R 5 E S 7 W 7 miles E of Cone (distance) (direction) (nearest town)	White Sand	10	45
WELL PURPOSE: Home (home, irrigation, municipal, industrial)	White Clay + Sand	45	175
WELL COMPLETION DATA: (1) diameter (inches) 4" (2) total depth (feet) 210 (3) static water level (feet) 130 below top of ground. (4) casing PVC 210 (material) (depth) If telescope see back. (5) screen 7' 203 (length) (depth to top) 4" gravel top (size) (material) (6) pump 3/4 18 (HP) (yield gpm) 110V (type power) (7) electric log No (yes or no) (organization running log) (8) how well bottom plugged Cap	White Sand	175	210
DRILLERS REMARKS:			

RECEIVED
NOV 13 1978

MISS. BD. OF WATER COMM.

If well telescopes please sketch and show depths.

GROUND LEVEL

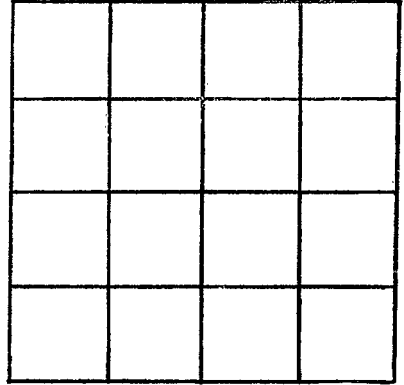

SECTION _____

Please indicate well location X.

ADDITIONAL INFORMATION

If more than one screen, show locations of each on sketch.