

PANOLA  
 D 2019  
 11-10-78

MISSISSIPPI  
 BOARD OF WATER COMMISSIONERS  
 416 North State Street  
 Jackson, Mississippi 39201

WATER WELL DRILLERS LOG

11-10-78 date well completed  
 Hicks Well Co firm name  
 Panola county well located

LANDOWNER: K. P. Massey  
 Rt. 1  
 Cone, Mo.  
 (mailing address)

description of formations encountered	from	to
Red clay	0	10
Red sand	10	45
White Clay + Sand	45	100
White sand	100	155

WELL LOCATION:  
 sec. 33 T-6 N R-6 E  
 6 miles E of Cone  
 (distance) (direction) (nearest town)

WELL PURPOSE: Home  
 (home, irrigation, municipal, industrial)

WELL COMPLETION DATA:

(1) diameter (inches) 4"

(2) total depth (feet) 155

(3) static water level (feet) 120 below above top of ground.

(4) casing PVC 155 (material) (depth)

(size) if telescope see back.

(5) screen 7' 148 (length) (depth to top)

4 gravel type (size) (material)

(6) pump 1/2 10 (HP) (yield gpm)

220V (type power)

(7) electric log No (yes or no)

(organization running log)


(8) how well bottom plugged Cap

DRILLERS REMARKS:

RECEIVED  
 DEC 14 1978

If well telescopes please sketch and show depths.

GROUND LEVEL

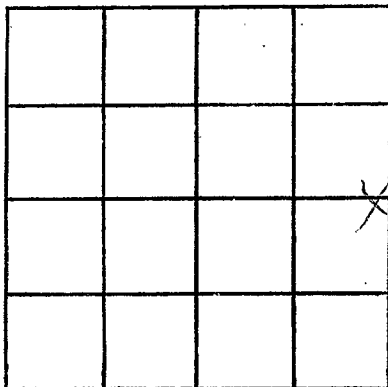

SECTION 33

Please indicate well location X.

ADDITIONAL INFORMATION

If more than one screen, show locations of each on sketch.