

PANOLA
D 2020
11-09-78

**MISSISSIPPI  
BOARD OF WATER COMMISSIONERS**  
416 North State Street  
Jackson, Mississippi 39201

**WATER WELL DRILLERS LOG**

11-9-78      Highwell Co      Panola  
 date well completed      firm name      county well located

**LANDOWNER:** James Clark  
 Rt. 1  
 Ceno, Ms.  
 (mailing address)

description of formations encountered	from	to
	Red Clay	0
Red Sand	10	30

**WELL LOCATION:**  
 sec 29 T 6 N R 5 E  
 1/2 miles W of Donnville  
 (distance) (direction) (nearest town)

White Sand	30	195
------------	----	-----

**WELL PURPOSE:** Home  
 (home, irrigation, municipal, industrial)

**WELL COMPLETION DATA:**

(1) diameter (inches) 4

(2) total depth (feet) 195

(3) static water level (feet) 150 below above top of ground.

(4) casing PVC 195 (material) (depth)  
 (size) if telescope see back.

(5) screen 7' 188 (length) (depth to top)  
 4 gravel type (size) (material)

(6) pump 3/4 10 (HP) (yield gpm)  
 2.20V (type power)

(7) electric log No (yes or no)

(organization running log)

(8) how well bottom plugged Cap


**RECEIVED**  
 DEC 14 1978

**DRILLERS REMARKS:**

OF WATER COMMISSIONERS

If well telescopes please sketch and show depths.

GROUND LEVEL

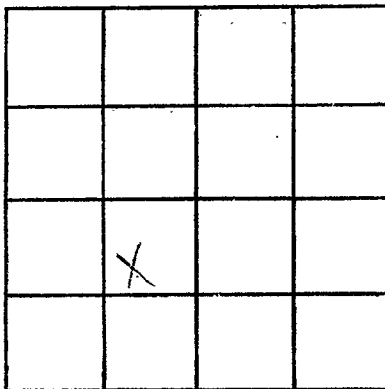

SECTION 29

Please indicate well location X.

ADDITIONAL INFORMATION

If more than one screen, show locations of each on sketch.