

Panola
D 2001

MISSISSIPPI
BOARD OF WATER COMMISSIONERS
416 North State Street
Jackson, Mississippi 39201

WATER WELL DRILLERS LOG

11-2 1978 LiPe well co. Panola
date well completed firm name county well located

LANDOWNER:	description of formations encountered	from	to
<u>Lewis Powell</u> <u>COMO Ms.</u> (mailing address)			
	<u>Clay</u>	<u>20</u>	<u>40</u>
	<u>sand</u>	<u>40</u>	<u>60</u>
	<u>ll</u>	<u>60</u>	<u>120</u>
	<u>Clay and Sand</u>	<u>120</u>	<u>140</u>
	<u>ll ll ll</u>	<u>140</u>	<u>160</u>
	<u>ll ll ll</u>	<u>160</u>	<u>180</u>
	<u>Good sand</u>	<u>180</u>	<u>203</u>
WELL LOCATION: sec. <u>19</u> T. <u>3</u> N. R. <u>5</u> E. <u>6</u> S. <u>W</u> <u>10</u> miles <u>east</u> of <u>COMO</u> (distance) (direction) (nearest town)			
WELL PURPOSE: (<u>home</u> irrigation, municipal, industrial)			
WELL COMPLETION DATA:			
(1) diameter (inches) <u>4</u>			
(2) total depth (feet) <u>203</u>			
(3) static water level (feet) <u>60</u> above top of ground.			
(4) casing <u>PVC</u> <u>193</u> (material) (depth)			
<u>4</u> if telescope see back. (size)			
(5) screen <u>10</u> <u>193</u> (length) (depth to top)			
<u>4</u> <u>PVC</u> (size) (material)			
(6) pump <u>3/4</u> <u>10</u> (HP) (yield gpm)			
<u>elec.</u> (type power)			
(7) electric log <u>No</u> (yes or no)			
<u>No</u> (organization running log)			
(8) how well bottom plugged <u>PVC</u> <u>PLUG</u>			
DRILLERS REMARKS:			


RECEIVED
NOV 20 1978

DEC - 4 1978

OF WATER COMMISSIONERS

If well telescopes please sketch and show depths.

GROUND LEVEL

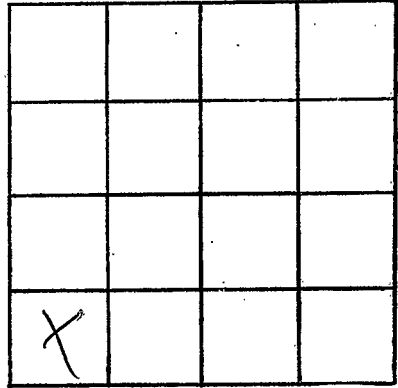

SECTION 19

Please indicate well location X.

ADDITIONAL INFORMATION

If more than one screen, show locations of each on sketch.