

PANOLA
D. 2023
5-1-79

MISSISSIPPI
BOARD OF WATER COMMISSIONERS
416 North State Street
Jackson, Mississippi 39201

WATER WELL DRILLERS LOG

5-1 1979 Rich Well Co Panola
date well completed firm name county well located

LANDOWNER:	description of formations encountered	from	to
Ray Zalden Pt. 1, Como Miss. (mailing address)		Red Clay	0
WELL LOCATION: sec. 29 T. 6 N. R. 5 E 1 miles (distance) of Bonville (nearest town)	Red Clay + Red Sand	25	95
WELL PURPOSE: home (home, irrigation, municipal, industrial)	Red Sand	95	160
WELL COMPLETION DATA: (1) diameter (inches) 4 in	White sand	160	215
(2) total depth (feet) 215			
(3) static water level (feet) 140 below top of ground			
(4) casing (material) Plastic (depth) 215			
(5) screen (length) 7 ft (depth to top) 205			
(6) pump (HP) 1/2 (yield gpm) 10			
(7) electric log (yes or no) No			
(8) how well bottom plugged Cap			
DRILLERS REMARKS:			


Miss. Board of Water Comm.

MAY 15 1979

RECEIVED

If well telescopes please sketch and show depths.

GROUND LEVEL

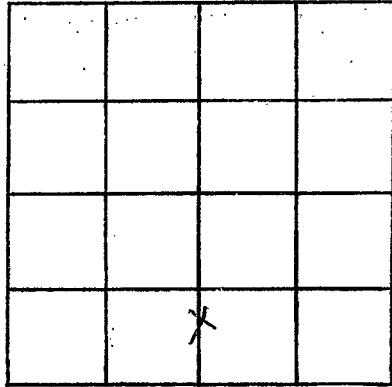

SECTION 29

Please indicate well location X.

ADDITIONAL INFORMATION

If more than one screen,
show locations of each on sketch.