

PANOLA
D 228
7-30-80

MISSISSIPPI
BOARD OF WATER COMMISSIONERS
416 North State Street
Jackson, Mississippi 39201

WATER WELL DRILLERS LOG

7-30 1980 date well completed High Wells firm name Panola county well located

LANDOWNER James Frank Hill

description of formations encountered

from to

Pat
Come, Mo.
(mailing address)

Clay 0 30
Red Sand 30 140
White Sand 140 185

WELL LOCATION:
sec 21 T 6 N R 5 E
3 miles S of Tebo
(distance) (direction) (nearest town)

WELL PURPOSE: Domestic
(home, irrigation, municipal, industrial)

WELL COMPLETION DATA:

- (1) diameter (inches) 4
- (2) total depth (feet) 185
- (3) static water level (feet) 140 below top of ground.
- (4) casing PVC, 180 (material), (depth)
- (size) if telescope see back.
- (5) screen 7', 178 (length), (depth to top)
- 1/2", gravel type (size), (material)
- (6) pump 1/2, 121 (HP), (yield gpm)
- 220V (type power)
- (7) electric log no (yes or no)

(organization running log)

(8) how well bottom plugged Cap

DRILLERS REMARKS:


DEPT. OF NATURAL RESOURCES
BUREAU OF LAND & WATER RESOURCES

SEP 26 1980

RECEIVED

If well telescopes please sketch and show depths.

GROUND LEVEL

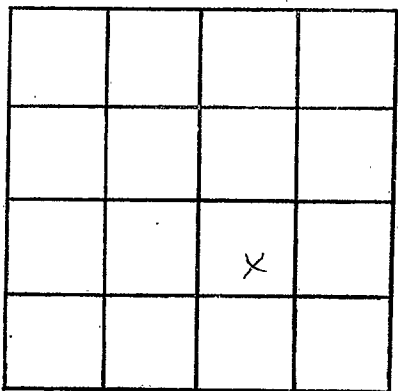

SECTION 21

Please indicate well location X.

ADDITIONAL INFORMATION

If more than one screen, show locations of each on sketch.