

PANOLA  
D 2029  
10-9-80

MISSISSIPPI  
 BOARD OF WATER COMMISSIONERS  
 416 North State Street  
 Jackson, Mississippi 39201

WATER WELL DRILLERS LOG

10-9 1980 Hicks Well Co. Panola  
 date well completed firm name county well located

LANDOWNER: <u>Roy Jackson</u> <u>Rt. 1 Box 294</u>	description of formations encountered	from	to
<u>Como, Mo.</u> (mailing address)	<u>Red clay</u>	<u>0</u>	<u>15</u>
WELL LOCATION: sec <u>29</u> T <u>6</u> N R <u>5</u> E _____ miles _____ of <u>Idaeville</u> (distance) (direction) (nearest town)	<u>clay + sand</u>	<u>15</u>	<u>115</u>
WELL PURPOSE: <u>Home</u> (home, irrigation, municipal, industrial)	<u>white sand</u>	<u>115</u>	<u>215</u>
WELL COMPLETION DATA:			
(1) diameter (inches) <u>4</u>			
(2) total depth (feet) <u>215</u>			
(3) static water level (feet) <u>170</u> <sup>below</sup> <del>above</del> top of ground.			
(4) casing <u>PVC</u> , <u>215</u> , (material) (depth)  _____ if telescope see back. (size)			
(5) screen <u>12</u> , <u>203</u> (length) (depth to top)			
(6) pump <u>4"</u> <u>gravel + slotted</u> (size) (material)			
(6) pump <u>3/4</u> <u>10</u> (HP) (yield gpm)			
(7) electric log <u>No</u> (yes or no)			
(8) how well bottom plugged <u>Cap</u> (organization running log)			
DRILLERS REMARKS:			


DEPT. OF NATURAL RESOURCES  
 BUREAU OF LAND & WATER RESOURCES

OCT 29 1980

RECEIVED

If well telescopes please sketch and show depths.

GROUND LEVEL

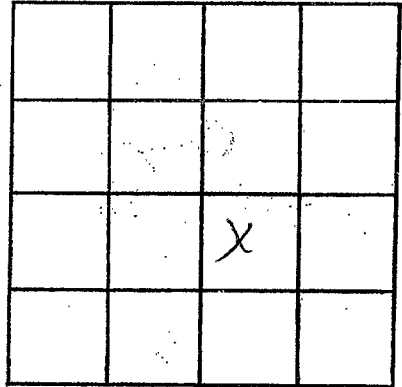

SECTION 29

Please indicate well location X.

ADDITIONAL INFORMATION

If more than one screen, show locations of each on sketch.