

MISSISSIPPI DEPARTMENT OF NATURAL RESOURCES

Bureau of Land and Water Resources

Southport Mall

P.O. Box 10631

Jackson, Mississippi 39209

WATER WELL DRILLERS LOG

Parola  
D 2030  
6-22-81

6-22-81 date well completed      Hicks Well Co. firm name      Parola county well located

LANDOWNER: John Smith  
RD. 1 Box 319  
Parola, Mo.  
 (mailing address)

description of formations encountered	from	to
<u>Red Clay</u>	<u>0</u>	<u>10</u>
<u>White Sand</u>	<u>10</u>	<u>170</u>
<u>Rock</u>	<u>170</u>	<u>171</u>
<u>Black Clay</u>	<u>171</u>	<u>200</u>
<u>Rock</u>	<u>200</u>	<u>207</u>
<u>White Sand</u>	<u>207</u>	<u>245</u>

WELL LOCATION:  
 sec. 29 T 6 N. R. 5 E  
1 miles NE of Parola  
 (distance) (direction) (nearest town)

WELL PURPOSE: Home  
 (home, irrigation, municipal, industrial)

WELL COMPLETION DATA:

(1) diameter (inches) 4

(2) total depth (feet) 245

(3) static water level (feet) 160 below above top of ground.

(4) casing PVC, 245,  
 (material) (depth)

12 If telescope see back.  
 (size)

(5) screen 12, 233  
 (length) (depth to top)

21", gravel & PVC  
 (size) (material)

(6) pump 3/4, 10  
 (HP) (yield gpm)


220V  
 (type power)

(7) electric log No  
 (yes or no)

(organization running log)


(8) how well bottom plugged Cap

DRILLERS REMARKS:

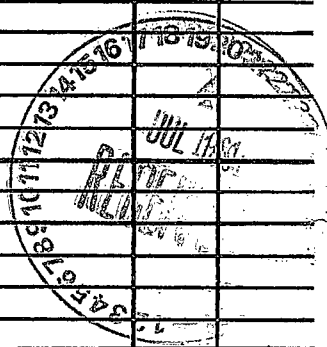

If well telescopes please sketch and show depths.

GROUND LEVEL

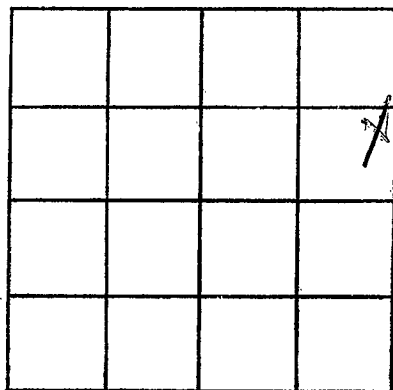

SECTION 29

Please indicate well location X.

ADDITIONAL INFORMATION

If more than one screen,  
show locations of each on sketch.