

MISSISSIPPI DEPARTMENT OF NATURAL RESOURCES

Bureau of Land and Water Resources

Southport Mall

P.O. Box 10631

Jackson, Mississippi 39209

WATER WELL DRILLERS LOG

Panola
D 2031
7-14-81

7-14 1981 Hicks Well Co. Panola
 date well completed firm name county well located

LANDOWNER: <u>Bessie Mae Phillip</u> <u>Rt. 1</u>	description of formations encountered	from	to
		<u>Cono, Ms.</u> (mailing address)	<u>Red Sand</u>
	<u>White Sand</u>	<u>35</u>	<u>140</u>

WELL LOCATION:
 sec. 26 T. 6 N. R. 6 E
5 miles SW of Tupelo
 (distance) (direction) (nearest town)


WELL PURPOSE: Home
 (home, irrigation, municipal, industrial)

- WELL COMPLETION DATA:
- (1) diameter (inches) ~~4~~ 4"
 - (2) total depth (feet) 140
 - (3) static water level (feet) 112 below above top of ground.
 - (4) casing PVC, 140,
 (material) (depth)
 - If telescope see back.
 (size)
 - (5) screen 7', 133
 (length) (depth to top)
 - 4", gravel type
 (size) (material)
 - (6) pump 1/2, 10
 (HP) (yield gpm)
 - 220V
 (type power)
 - (7) electric log No
 (yes or no)

(organization running log)

(8) how well bottom plugged Cap

DRILLERS REMARKS:

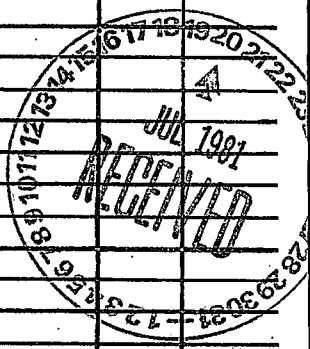

If well telescopes please sketch and show depths.

GROUND LEVEL

			X

SECTION 26

Please indicate well location X.

ADDITIONAL INFORMATION

If more than one screen,
show locations of each on sketch.