

MISSISSIPPI DEPARTMENT OF NATURAL RESOURCES

Bureau of Land and Water Resources

Southport Mall

P.O. Box 10631


Jackson, Mississippi 39209

WATER WELL DRILLERS LOG

PANOLA
D 2032
7-20-81


7-20 19 81 date well completed
Hicks Well B. firm name
Panola county well located

LANDOWNER: <u>Bentley Baptist Church</u>	description of formations encountered	from	to
<u>Rt. 1</u>			
<u>Como, Mo.</u> (mailing address)	<u>Red Clay</u>	<u>0</u>	<u>5</u>
	<u>Red Sand</u>	<u>5</u>	<u>20</u>
WELL LOCATION: sec. <u>27</u> T- <u>6</u> N R- <u>6</u> E <u>4 1/2</u> miles <u>W</u> of <u>Stemille</u> (distance) (direction) (nearest town)	<u>Broken Clay</u>	<u>20</u>	<u>80</u>
	<u>Gravel</u>	<u>80</u>	<u>95</u>
WELL PURPOSE: <u>Church</u> (home, irrigation, municipal, industrial)	<u>White Sand</u>	<u>95</u>	<u>142</u>
WELL COMPLETION DATA: (1) diameter (inches) <u>4</u>			
(2) total depth (feet) <u>142</u>			
(3) static water level (feet) <u>100</u> below above top of ground.			
(4) casing <u>PVC</u> <u>142</u> (material) (depth)			
<u>—</u> if telescope see back. (size)			
(5) screen <u>12</u> <u>130</u> (length) (depth to top)			
<u>4"</u> <u>gravel + PVC</u> (size) (material)			
(6) pump <u>1/2</u> <u>10</u> (HP) (yield gpm)			
<u>115V</u> (type power)			
(7) electric log <u>No.</u> (yes or no)			
(organization running log)			
(8) how well bottom plugged <u>Cap</u>			
DRILLERS REMARKS:			

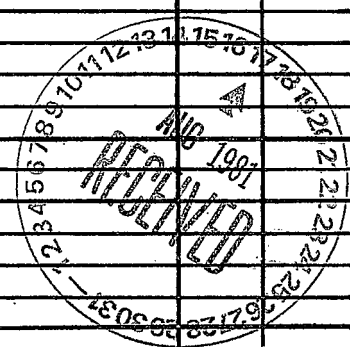

If well telescopes please sketch and show depths.

GROUND LEVEL

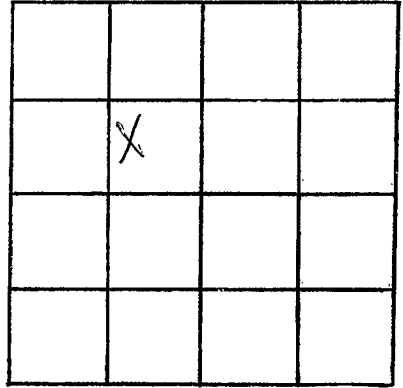

SECTION 27

Please indicate well location X.

ADDITIONAL INFORMATION

If more than one screen,
show locations of each on sketch.