

MISSISSIPPI DEPARTMENT OF NATURAL RESOURCES

Bureau of Land and Water Resources

Southport Mall

P.O. Box 10631

Jackson, Mississippi 39209

WATER WELL DRILLERS LOG

Panola
D
2033

8-12 1982
date well completed

HICKS WELL CO.
RT. 1, Box 157
Senatobia, MS 38668

Panola
county well located

LANDOWNER: Curley Redmon
1273 Edith St.
Memphis, Tenn. 38106
(mailing address)

description of formations encountered	from	to
<u>Red sand</u>	<u>0</u>	<u>20</u>
<u>white sand</u>	<u>20</u>	<u>80</u>
<u>White Sand + clay</u>	<u>80</u>	<u>140</u>
<u>White sand + clay</u>	<u>140</u>	<u>170</u>

WELL LOCATION:
sec. 30 T 6 N R 5 E
2 miles W of Slouville
(distance) (direction) (nearest town)

WELL PURPOSE: home
(home, irrigation, municipal, industrial)

WELL COMPLETION DATA:

(1) diameter (inches) 4

(2) total depth (feet) 170

(3) static water level (feet) 120 below top of ground.

(4) casing PVC 170
(material) (depth)
4" if telescope see back.
(size)

(5) screen 10 160
(length) (depth to top)
013 PVC
(size) (material)

(6) pump 1/2 10
(HP) (yield gpm)
220V
(type power)

(7) electric log No
(yes or no)

(organization running log)

(8) how well bottom plugged Cap

DRILLERS REMARKS:


DEPT. OF NATURAL RESOURCES
BUREAU OF LAND & WATER RESOURCES

AUG 27 1982

RECEIVED

If well telescopes please sketch and show depths.

GROUND LEVEL

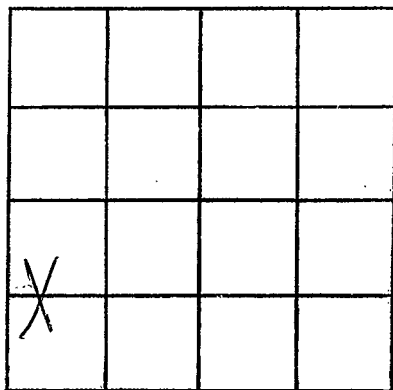

SECTION 30

Please indicate well location X.

ADDITIONAL INFORMATION

If more than one screen,
show locations of each on sketch.