

MISSISSIPPI DEPARTMENT OF NATURAL RESOURCES

Bureau of Land and Water Resources

Southport Mall

P.O. Box 10631

Jackson, Mississippi 39209

WATER WELL DRILLERS LOG

Panola
D
2034

4-15-82
 date well completed

Bob Smith (Panola)
 firm name county well located

LANDOWNER:	description of formations encountered	from	to
<u>Rudell Moore</u> <u>Como, ms.</u> (mailing address)			
	<u>red clay</u>	<u>5</u>	<u>30</u>
	<u>gravel</u>	<u>20</u>	<u>70</u>
	<u>white clay</u>	<u>70</u>	<u>150</u>
	<u>sand</u>	<u>150</u>	<u>300</u>

WELL LOCATION:
 sec. 28 T 6 N R 6 E
 (distance) miles (direction) of (nearest town)
14 miles N.E. of Como

WELL PURPOSE:
 (home, irrigation, municipal, industrial)
home

- WELL COMPLETION DATA:
- diameter (inches) 4"
 - total depth (feet) 200'
 - static water level (feet) 130 below above top of ground.
 - casing plastic 200'
(material) (depth)
 - _____ if telescope see back.
(size)
 - screen 20 180'
(length) (depth to top)
4" plastic
(size) (material)
 - pump 1/2 10
(HP) (yield gpm)
elec.
(type power)
 - electric log (yes) (no)
(organization running log)
 - how well bottom plugged cap

DEPT. OF NATURAL RESOURCES
 BUREAU OF LAND & WATER RESOURCES


OCT 12 1982

RECEIVED

DRILLERS REMARKS:

If well telescopes please sketch and show depths.

GROUND LEVEL

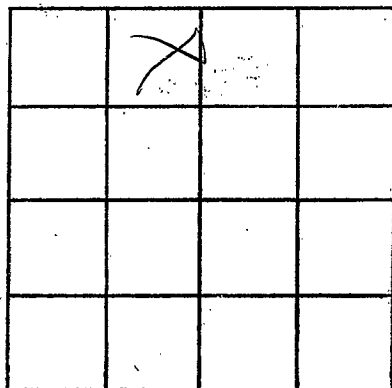

SECTION _____

Please indicate well location X.

ADDITIONAL INFORMATION

If more than one screen,
show locations of each on sketch.