

Panola
D
2035

MISSISSIPPI
 BOARD OF WATER COMMISSIONERS
 416 North State Street
 Jackson, Mississippi 39201

WATER WELL DRILLERS LOG

4-28 1983 BIG STREAM PANOLA
 date well completed firm name county well located

LANDOWNER:	description of formations encountered	from	to
<u>PAUL FREEMAN</u>	<u>BRD CLAY</u>	<u>0</u>	<u>60</u>
<u>COMO MISS</u>	<u>Shaly</u>	<u>60</u>	<u>110</u>
(mailing address)	<u>Sand</u>	<u>110</u>	<u>140</u>
WELL LOCATION:			
sec. <u>19</u> T. <u>6</u> N. R. <u>6</u> E.			
S. <u>W</u> W. <u>W</u>			
<u>4</u> miles <u>E</u> of <u>COMO</u>			
(distance) (direction) (nearest town)			
WELL PURPOSE: (home, irrigation, municipal, industrial)			
WELL COMPLETION DATA:			
(1) diameter (inches) <u>4"</u>			
(2) total depth (feet) <u>140</u>			
(3) static water level (feet) <u>90</u> below top of ground.			
(4) casing <u>PLAST</u> <u>BD</u>			
(material) (depth)			
<u>4"</u> if telescope see back.			
(size)			
(5) screen <u>10</u> <u>130</u>			
(length) (depth to top)			
<u>4"</u> <u>PLAST</u>			
(size) (material)			
(6) pump <u>3/4</u> <u>10</u>			
(HP) (yield, gpm)			
<u>ELECT</u>			
(type power)			
(7) electric log <u>NO</u>			
(yes or no)			
(organization running log)			
(8) how well bottom plugged <u>WASHB</u>			
DRILLERS REMARKS:			


DEPT. OF NATURAL RESOURCES
 BUREAU OF LAND & WATER RESOURCES

MAY 23 1983

RECEIVED

If well telescopes please sketch and show depths.

GROUND LEVEL

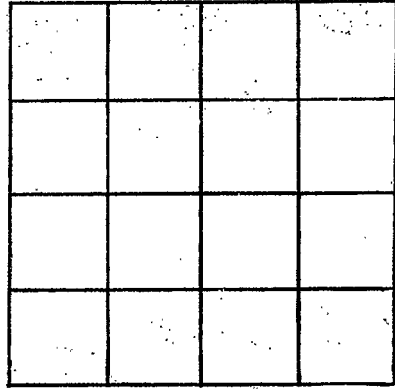

SECTION _____

Please indicate well location X.

ADDITIONAL INFORMATION

If more than one screen, show locations of each on sketch.