

MISSISSIPPI DEPARTMENT OF NATURAL RESOURCES
 Bureau of Land and Water Resources
 Southport Mall
 P.O. Box 10631
 Jackson, Mississippi 39209
WATER WELL DRILLERS LOG

Panola
D
2036

6-27 1983
 date well completed

NICKS WELL CO.
 name of contractor

Panola
 county well located

LANDOWNER: Francis Bentley
Pl. 1 Hwy #310E
Came, Miss. 38619
 (mailing address)

description of formations encountered	from	to
<u>Red clay</u>	<u>0</u>	<u>10</u>
<u>White clay</u>	<u>10</u>	<u>15</u>
<u>Rock</u>	<u>15</u>	<u>16</u>
<u>Red sand</u>	<u>16</u>	<u>40</u>
<u>White sand</u>	<u>40</u>	<u>125</u>
<u>White sand + clay</u>	<u>125</u>	<u>160</u>
<u>White sand</u>	<u>160</u>	<u>205</u>

WELL LOCATION:
 sec. 30 T. 6 N. R. 5 E.
1 miles W of Deleville
 (distance) (direction) (nearest town)

WELL PURPOSE: Home
 (home, irrigation, municipal, industrial)

WELL COMPLETION DATA:

- (1) diameter (inches) 4
- (2) total depth (feet) 205
- (3) static water level (feet) 160 ^{below}/_{above} top of ground.
- (4) casing PVC, 205
 (material) (depth)
4"
 (size) If telescope see back.
- (5) screen 10', 195'
 (length) (depth to top)
.013, PVC
 (size) (material)
- (6) pump 3/4hp, 10
 (HP) (yield gpm)
220V
 (type power)
- (7) electric log No
 (yes or no)
 (organization running log)
- (8) how well bottom plugged Caps

DRILLERS REMARKS:


DEPT. OF NATURAL RESOURCES
 BUREAU OF LAND & WATER RESOURCES

AUG 11 1983

RECEIVED

If well telescopes please sketch and show depths.

GROUND LEVEL

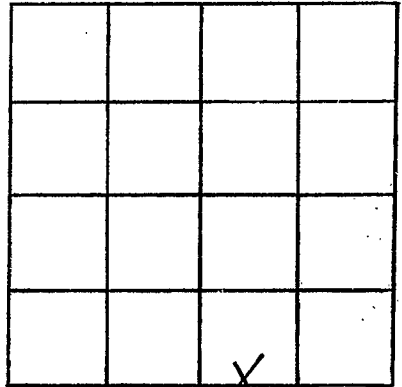

SECTION 30

Please indicate well location X.

ADDITIONAL INFORMATION

If more than one screen, show locations of each on sketch.