

BOARD OF WATER COMMISSIONERS

416 North State Street

Jackson, Mississippi 39201

Panola

D 2037

WATER WELL DRILLERS LOG

September 27 1983
date well completed

Sipoll Water Supply
firm name

Panola
county well located

LANDOWNER: <i>W.S. Taylor</i>	description of formations encountered	from	to
(mailing address)	<i>top soil clay sand</i>	<i>0</i>	<i>20</i>
WELL LOCATION: sec <u>21</u> T <u>6</u> N R <u>6</u> E <u>6</u> miles <u>E</u> of <u>Como</u> (distance) (direction) (nearest town)	<i>sand</i>	<i>20</i>	<i>80</i>
WELL PURPOSE: (home, irrigation, municipal, industrial)	<i>sand clay</i>	<i>80</i>	<i>120</i>
WELL COMPLETION DATA:	<i>DEMAND</i>	<i>120</i>	<i>145</i>
(1) diameter (inches) <u>4"</u>			
(2) total depth (feet) <u>147</u>			
(3) static water level (feet) <u>60</u> ^{below} / _{above} top of ground.			
(4) casing <u>PVC</u> , <u>132</u> (material) (depth)			
<u>4</u> (size) if telescope see back.			
(5) screen <u>10</u> , <u>132</u> (length) (depth to top)			
<u>4"</u> , <u>PVC</u> (size) (material)			
(6) pump <u>1/2</u> , <u>10</u> (HP) (yield gpm)			
<u>elec</u> (type power)			
(7) electric log <u>(yes or no)</u>			
(organization running log)			
(8) how well bottom plugged <u>PVC cap</u>			
DRILLERS REMARKS:			


DEPT. OF NATURAL RESOURCES
BUREAU OF LAND & WATER RESOURCES

SEP 30 1983

RECEIVED

If well telescopes please sketch and show depths.

GROUND LEVEL

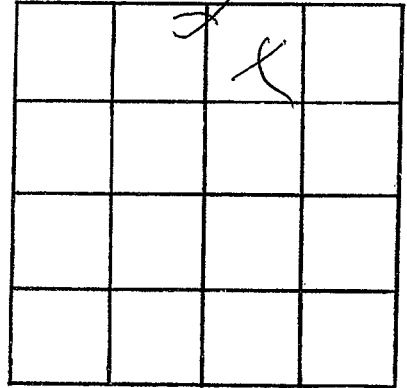

SECTION _____

Please indicate well location X.

ADDITIONAL INFORMATION

If more than one screen,
show locations of each on sketch.