

MISSISSIPPI DEPARTMENT OF NATURAL RESOURCES

Bureau of Land and Water Resources

Southport Mall

P.O. Box 10631

Jackson, Mississippi 39209

WATER WELL DRILLERS LOG

Panda
D
2038

HICKS WELL CO.
firm name BOX 157
Senatobia MS 39068

Panda

5/16 1984
date well completed

county well located

LANDOWNER: *Jack Freeman*
Rt. 1
Cano, Mo. 38619
(mailing address)

description of formations encountered	from	to
<i>Red clay</i>	<i>0</i>	<i>20</i>
<i>Red sand</i>	<i>20</i>	<i>50</i>
<i>white sand</i>	<i>50</i>	<i>170</i>

WELL LOCATION:
sec. 30 T. 6 N. R. 5 E.
2 miles W of Blennville
(distance) (direction) (nearest town)

WELL PURPOSE: Home
(home, irrigation, municipal, industrial)

WELL COMPLETION DATA:

- (1) diameter (inches) 4
- (2) total depth (feet) 170
- (3) static water level (feet) 140 below above top of ground.
- (4) casing PVC 170
(material) (depth)
4"
(size) if telescope see back.
- (5) screen 10' 160'
(length) (depth to top)
0.16 PVC
(size) (material)
- (6) pump 1/2 10
(HP) (yield gpm)
220V
(type power)
- (7) electric log No
(yes or no)
(organization running log)
- (8) how well bottom plugged Cap


DRILLERS REMARKS:

DEPT. OF NATURAL RESOURCES
BUREAU OF LAND & WATER RESOURCES

MAY 23 1984
RECEIVED

If well telescopes please sketch and show depths.

GROUND LEVEL

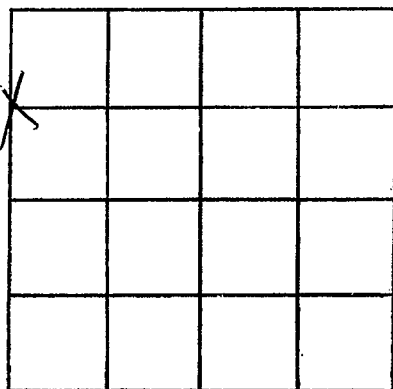

SECTION 30

Please indicate well location X.

ADDITIONAL INFORMATION

If more than one screen, show locations of each on sketch.