

MISSISSIPPI DEPARTMENT OF NATURAL RESOURCES

Bureau of Land and Water Resources

Southport Mall

P.O. Box 10631

Jackson, Mississippi 39209

WATER WELL DRILLERS LOG

PANOLA
D 2039

5/29 1984

HICKS WELL CO.
P.O. Box 157
Panola, MS 38668

Panola

date well completed

firm name

county well located

LANDOWNER: Clifton Bowden
Re. 1 Box 423
Sardin, Ms. 38666
(mailing address)

description of formations encountered	from	to
Red Clay	0	10
Red sand	10	30
White Sand & Clay	30	60
White Sand	60	135

WELL LOCATION:
sec. 27 T. 6 N. R. 6 E
4 miles W of Stennisville
(distance) (direction) (nearest town)

WELL PURPOSE: Home
(home, irrigation, municipal, industrial)

WELL COMPLETION DATA:

(1) diameter (inches) 4

(2) total depth (feet) 135

(3) static water level (feet) 100 below top of ground.

(4) casing PVC 135
(material) (depth)

4 if telescope see back.
(size)

(5) screen 10 125
(length) (depth to top)

1 0/10 PVC
(size) (material)

(6) pump 1/2 10
(HP) (yield gpm)

220V
(type power)

(7) electric log No
(yes or no)

(organization running log)

(8) how well bottom plugged Caps

DRILLERS REMARKS:


DEPT. OF NATURAL RESOURCES
BUREAU OF LAND & WATER RESOURCES

JUL 10 1984

RECEIVED

If well telescopes please sketch and show depths.

GROUND LEVEL

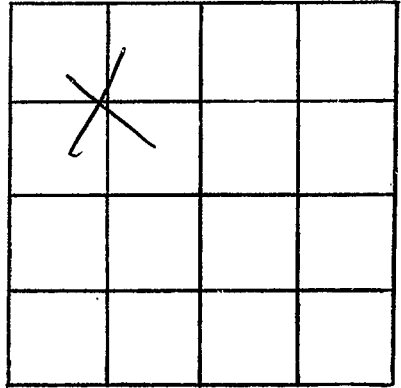

SECTION 27

Please indicate well location X.

ADDITIONAL INFORMATION

If more than one screen,
show locations of each on sketch.