

MISSISSIPPI DEPARTMENT OF NATURAL RESOURCES

Bureau of Land and Water Resources

Southport Mall

P.O. Box 10631

Jackson, Mississippi 39209

WATER WELL DRILLERS LOG

D 2042
Panola
7-2-85

7-2 19 85
 date well completed

HICKS WELL COMPANY

Panola
 county well located

Rt. 1 firm name

SENATORIA, MISS.

LANDOWNER: Ray Warren

description of formations encountered

from to

3088 Kirby Down Cove

Memphis TN
 (mailing address)

Red Clay

0 10

Red sand

10 30

White sand

30 170

WELL LOCATION:

sec. 33 T. 6 N. R. 5 E
2 miles W of Harmon Town
 (distance) (direction) (nearest town)

WELL PURPOSE: Home
 (home, irrigation, municipal, industrial)

WELL COMPLETION DATA:

- (1) diameter (inches) 4"
- (2) total depth (feet) 170'
- (3) static water level (feet) 100 ^{below} top of ground.
- (4) casing PVC (material), 160' (depth)
4" (size) if telescope see back.
- (5) screen 10' (length), 160' (depth to top)
0.13 (size), PVC (material)
- (6) pump 1/2 (HP), 10 (yield gpm)
220 V (type power)
- (7) electric log NO (yes or no)
 (organization running log)
- (8) how well bottom plugged Cap


RECEIVED
 SEP 26 1985

DRILLERS REMARKS:

Department of Natural Resources
 Bureau of Land & Water Resources

If well telescopes please sketch and show depths.

GROUND LEVEL

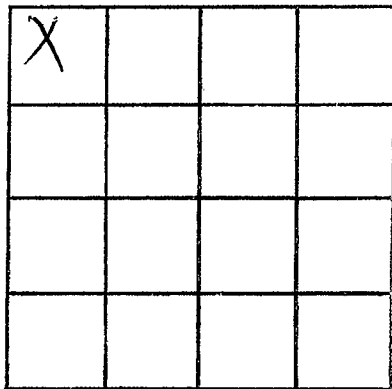

SECTION 33

Please indicate well location X.

ADDITIONAL INFORMATION

If more than one screen,
show locations of each on sketch.