

MISSISSIPPI DEPARTMENT OF NATURAL RESOURCES

Bureau of Land and Water Resources

Southport Mall

P.O. Box 10631

Jackson, Mississippi 39209

WATER WELL DRILLERS LOG

HICKS WELL COMPANY

RT. 1 BOX 157

firm name

SENATORIA, MISS.

county well located

Panola
D 2043

date well completed 8-7 1985

Panola

LANDOWNER: Willie Milam
Rt #1 Box 290
Como MS 39619
(mailing address)

description of formations encountered	from	to
<u>Red clay</u>	<u>0</u>	<u>10</u>
<u>Red sand</u>	<u>10</u>	<u>50</u>
<u>White Sand & clay</u>	<u>50</u>	<u>100</u>
<u>White Sand</u>	<u>100</u>	<u>230</u>

WELL LOCATION:

sec. 26 T. 6 N. R. 5 E
S W
1 miles W of Harmon Town
(distance) (direction) (nearest town)

WELL PURPOSE: Home
(home, irrigation, municipal, industrial)

WELL COMPLETION DATA:

- (1) diameter (inches) 4"
- (2) total depth (feet) 220'
- (3) static water level (feet) 180 ^{below} above top of ground.
- (4) casing PVC, 220',
(material) (depth)
4"
(size) if telescope see back.
- (5) screen 10', 220'
(length) (depth to top)
.013, PVC
(size) (material)
- (6) pump 3/4, 10
(HP) (yield gpm)
220V
(type power)
- (7) electric log No
(yes or no)
(organization running log)
- (8) how well bottom plugged Cap

RECEIVED


NOV - 1 1985

DRILLERS REMARKS:

Department of Natural Resources
Bureau of Land & Water Resources

If well telescopes please sketch and show depths.

GROUND LEVEL

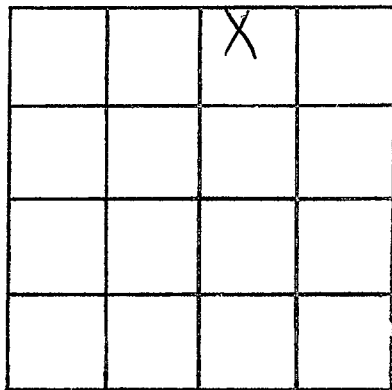

SECTION 26

Please indicate well location X.

ADDITIONAL INFORMATION

If more than one screen,
show locations of each on sketch.