

Bureau of Land and Water Resources

PERMIT NUMBER
NAME OF DRILLING FIRM
WICKS, WELLY, GILBERTSON

Jackson, Mississippi 39209
WATER WELL DRILLERS LOG

PUMP DATA			
PUMP TYPE (Circle One): <div style="display: flex; justify-content: space-between; align-items: flex-start;"> <u>Submersible</u>, Turbine, Jet Flowing Well, </div> Other (Describe) _____			
POWER TYPE (Circle One): <div style="display: flex; justify-content: space-between; align-items: flex-start;"> <u>Electric</u>, Tractor, Diesel, Gasoline, Butane, </div> Other (Describe) _____			
Pump Capacity (GPM) <div style="font-size: 2em; text-align: center; margin-top: 10px;">10</div>	No. of Stages <div style="font-size: 2em; text-align: center; margin-top: 10px;">9</div>	Setting Depth <div style="font-size: 2em; text-align: center; margin-top: 10px;">140</div>	
FT.			
PUMP TEST			
Well yielded _____ GPM with			
a drawdown of _____ ft.			
after _____ hours of pumping			

LOG DATA

TYPE OF LOG RUN (Circle One): No Log Run
Electric, Gamma Ray, Density, Sonic, Neutron,
Other (Describe) _____
Name of Organization Running Log _____

Surface Elev.	Geologic Unit	Unit Thickness	Depth to Top
Subs. SWL	Date	Analysis	Aquifer Test


Driller's Remarks

RECEIVED

[illegible]

If well telescopes please
sketch and show depths.

GROUND LEVEL

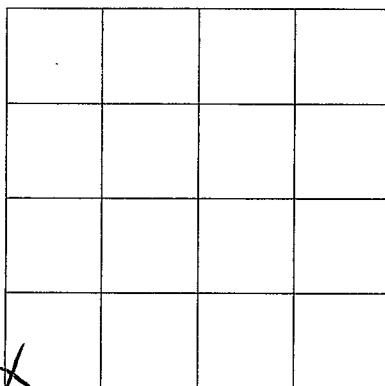

SECTION 30

Please indicate well location X.

ADDITIONAL INFORMATION

If more than one screen,
show location of each on sketch.