

MISSISSIPPI DEPARTMENT OF NATURAL RESOURCES

Bureau of Land and Water Resources

Southport Mall

P.O. Box 10631

Jackson, Mississippi 39209

WATER WELL DRILLERS LOG

Panola  
D 2061

10-19-91 19 19

Lipe Well & Supply Co. Panola

date well completed

firm name

county well located

LANDOWNER: Bill Davis  
Assoc. Equity Service, Inc.  
6101 Ridgeway Rd. Ste 4  
Jackson, MS 39211

description of formations encountered

from

to

WELL LOCATION:  
sec. 21 T. 6 N. R. 6 E.  
8 miles W of Como  
(distance) (direction) (nearest town)


<u>Top Soil, hard clay</u>	<u>0</u>	<u>20</u>
<u>Hard clay, red sand mixed w/ clay</u>	<u>20</u>	<u>40</u>
<u>Sand mixed w/ small pea gravel</u>	<u>40</u>	<u>60</u>
<u>Small pea gravel, gravel</u>	<u>60</u>	<u>80</u>
<u>Gravel w/ small shell rock sand streak</u>		
<u>clay, sand</u>	<u>80</u>	<u>100</u>
<u>sand</u>	<u>100</u>	<u>120</u>
<u>" "</u>	<u>120</u>	<u>140</u>
<u>" "</u>	<u>140</u>	<u>160</u>
<u>Sand to 172'</u>	<u>160</u>	<u>180</u>

WELL PURPOSE:  
(home, irrigation, municipal, industrial)

WELL COMPLETION DATA:

- (1) diameter (inches) 4"
- (2) total depth (feet) 172'
- (3) static water level (feet) 80' below top of ground.
- (4) casing PVC 164'  
(material) (depth)  
4"  
(size) if telescope see back.
- (5) screen 8' 164'  
(length) (depth to top)  
4" PVC  
(size) (material)
- (6) pump 3/4 10  
(HP) (yield gpm)  
elec  
(type power)
- (7) electric log (yes or no)  
(organization running log)
- (8) how well bottom plugged Capped

DRILLERS REMARKS:

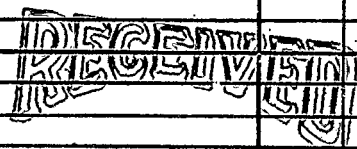

Dept. of Environmental Quality  
Bureau of Land & Water Resources

If well telescopes please sketch and show depths.

GROUND LEVEL


SECTION \_\_\_\_\_

Please indicate well location X.

ADDITIONAL INFORMATION

If more than one screen,  
show locations of each on sketch.