

**MISSISSIPPI DEPARTMENT OF ENVIRONMENTAL QUALITY**  
Bureau of Land and Water Resources

P. O. Box 10631  
Jackson, MS 39289-0631  
WATER WELL DRILLERS LOG

COUNTY WELL LOCATED <b>PANOLA</b>	
WELL NUMBER <b>D 2067</b>	CODED
DATE WELL COMPLETED <b>5-6-93</b>	

PERMIT NUMBER <b>HICKS WELL CO.</b>
NAME OF DRILLING FIRM <b>RTI BOX 157</b>
<b>SENATOBIA, MS 38668</b>

NAME & MAILING ADDRESS OF LANDOWNER <b>Onie Schumaker</b>			
<b>RTI Box 291</b>			
<b>Como MS</b>			
WELL LOCATION:	SEC	TOWNSHIP	RANGE
	<b>29</b>	<b>6</b>	<b>N 5 E</b>
DISTANCE	DIRECTION	NEAREST TOWN	
<b>8</b> Miles	<b>SW</b> of	<b>Como</b>	
OTHER LANDMARK			
WELL PURPOSE: <input checked="" type="checkbox"/> Home Irrigation, Municipal, Industrial, Fish Pond, etc.			

<b>PUMP DATA</b>		
PUMP TYPE (Circle One): <input checked="" type="checkbox"/> Submersible Turbine, Jet Flowing Well, Other (Describe) _____		
POWER TYPE (Circle One): <input checked="" type="checkbox"/> Electric, Tractor, Diesel, Gasoline, Butane, Other (Describe) _____ H/P <b>1 1/2</b>		
Pump Capacity (GPM) <b>23</b>	No. of Stages	Setting Depth <b>140</b> FT.
PUMP TEST		
Well yielded _____ GPM with a drawdown of _____ ft. after _____ hours of pumping		

<b>WELL DATA</b>		
Well Depth <b>215'</b>	Casing Diameter (In.) <b>4"</b>	Casing Length (Ft.) <b>200'</b>
Type of Casing <b>PVC</b>	Hole Depth <b>215</b>	Depth to Static Water Level <b>110'</b>
TYPE OF COMPLETION: (Circle One or More): <input checked="" type="checkbox"/> Gravel Packed, Underreamed, Telescoped, Natural Development, Open Hole, Other (Describe) _____		
Top of Lap Pipe or Reduction in Casing		
FEET	IF TELESKOPIED OR MORE THAN ONE SCREEN: USE BACK PAGE	

<b>LOG DATA</b>	
TYPE OF LOG RUN (Circle One): No Log Run, Electric, Gamma Ray, Density, Sonic, Neutron, Other (Describe) _____	
Name of Organization Running Log	

<b>SCREEN DATA</b>		
Diameter - Inches <b>4"</b>	Length - Feet <b>15</b>	Slot Size - Inches <b>.013</b>
Screen Type <b>PVC</b>	Depth to Bottom - Feet <b>15</b>	

<b>GEOLOGIC DATA (Office Use Only)</b>			
Surface Elev.	Geologic Unit	Unit Thickness	Depth to Top
Subs. SWL	Date	Analysis	Aquifer Test

Driller's Remarks


DESCRIPTION OF FORMATIONS ENCOUNTERED	FROM	TO	FORMATIONS (Continued)	FROM	TO
<b>Red Sand</b>	<b>0</b>	<b>60</b>	<b>RECEIVED</b>  <b>MAY 25 1993</b>		
<b>CLAY</b>	<b>60</b>	<b>140</b>			
<b>SAND &amp; CLAY</b>	<b>140</b>	<b>160</b>			
<b>White Sand</b>	<b>160</b>	<b>215</b>			

Dept. of Environmental Quality  
Office of Land & Water Resources

IF MORE SPACE IS NEEDED, USE BACK

If well telescopes please sketch and show depths.

GROUND LEVEL

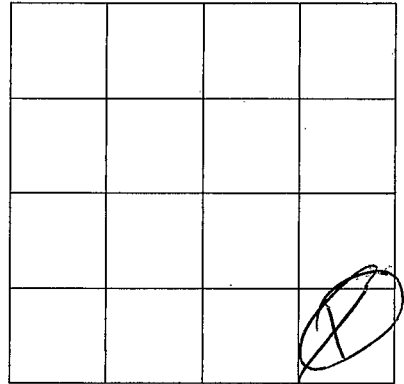

SECTION \_\_\_\_\_

Please indicate well location X.

ADDITIONAL INFORMATION

If more than one screen,  
show location of each on sketch.