

**MISSISSIPPI DEPARTMENT OF ENVIRONMENTAL
QUALITY**

Office of Land and Water Resources

COUNTY WELL LOCATED PANOLA	
WELL NUMBER D 2073	CODED
DATE WELL COMPLETED 10-25-95	

PERMIT NUMBER HICKS WELL CO.
NAME OF DRILLING FIRM RT. 1 BOX 157 SENATOBIA, MS 38668

P. O. Box 10631
Jackson, MS 39289-0631
WATER WELL DRILLERS LOG

NAME & MAILING ADDRESS OF LANDOWNER Joe Parker			
RT-1			
Como, MS			
WELL LOCATION:	SEC	TOWNSHIP	RANGE
	2	6 ^N _S	6 ^E _W
DISTANCE	DIRECTION	NEAREST TOWN	
12 Miles	E	of Como	
OTHER LANDMARK BY phone tower			
WELL PURPOSE: Home, Irrigation, Municipal, Industrial, Fish Pond, etc. Home			

PUMP DATA		
PUMP TYPE (Circle One): Submersible, Turbine, Jet, Flowing Well, Other (Describe) _____		
POWER TYPE (Circle One): <u>Electric</u> , Tractor, Diesel, Gasoline, Butane, Other (Describe) _____ H/P 3/4		
Pump Capacity (GPM)	No. of Stages	Setting Depth
10	12	160 FT.
PUMP TEST		
Well yielded _____ GPM with a drawdown of _____ ft. after _____ hours of pumping		

WELL DATA		
Well Depth	Casing Diameter (In.)	Casing Length (Ft.)
200'	4"	190'
Type of Casing	Hole Depth	Depth to Static Water Level
PVC	200	140
TYPE OF COMPLETION: (Circle One or More): <u>Gravel Packet</u> , Underreamed, Telescoped, Natural Development, Open Hole, Other (Describe) _____		
WELL GROUTED TO A DEPTH OF 10' FEET Type Grout (circle one): <u>Cement</u> , Bentonite, or Mix		

LOG DATA	
TYPE OF LOG RUN (Circle One): No Log Run, Electric, Gamma Ray, Density, Sonic, Neutron, Other (Describe) _____	
Name of Organization Running Log	

SCREEN DATA		
Diameter - Inches	Length - Feet	Slot Size - Inches
4"	10'	013
Screen Type	Depth to Bottom - Feet	
PVC	10'	

GEOLOGIC DATA (Office Use Only)			
Surface Elev.	Geologic Unit	Unit Thickness	Depth to Top
Subs. SWL	Date	Analysis	Aquifer Test
Driller's Remarks			
Top of Lap Pipe or Reduction in Casing			
FEET		IF TELESCOPED OR MORE THAN ONE SCREEN: USE BACK PAGE	


DESCRIPTION OF FORMATIONS ENCOUNTERED	FROM	TO	FORMATIONS (Continued)	FROM	TO
Red Sand	0	60	<div style="font-size: 2em; font-weight: bold; border: 2px solid black; padding: 5px; display: inline-block;">RECEIVED</div> <div style="font-size: 1.5em; font-weight: bold;">JAN 16 1996</div>		
Sand & Clay	60	120			
Clay	120	160			
White Sand	160	200			

IF MORE SPACE IS NEEDED, USE BACK

Dept. of Environmental Quality
Office of Land & Water Resources

If well telescopes please
sketch and show depths.

GROUND LEVEL

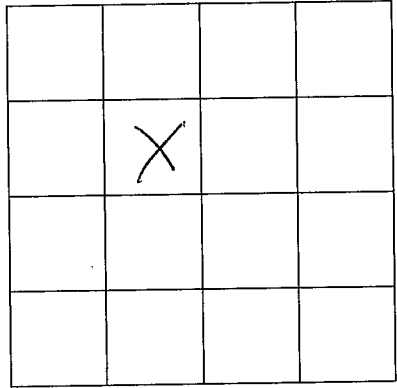

SECTION 2

Please indicate well location X.

ADDITIONAL INFORMATION

Lined area for additional information.

If more than one screen,
show location of each on sketch.