

MISSISSIPPI DEPARTMENT OF ENVIRONMENTAL QUALITY

Office of Land and Water Resources

P. O. Box 10631
Jackson, MS 39289-0631
WATER WELL DRILLERS LOG

COUNTRY WELL LOCATED PAINDOLA	
WELL NUMBER D 2077	CODED
DATE WELL COMPLETED 3-20-98	

PERMIT NUMBER
NAME HICK WATER WELL CO.
30242 HWY. 4 EAST
SENATOBIA, MS 38668

NAME & MAILING ADDRESS OF LANDOWNER Don Malmo		
5860 Ridgeway Ctr. Parkway		
Suite 404		
Memphis, TN 38120		
WELL LOCATION: SEC	TOWNSHIP	RANGE
35	6 N	6 E
DISTANCE	DIRECTION	NEAREST TOWN
4 Miles	W	Memphis
OTHER LANDMARK Highway 3100 Paul White Rd.		
WELL PURPOSE: Home, Irrigation, Municipal, Industrial, Fish Pond, etc.		

PUMP DATA		
PUMP TYPE (Circle One): <input checked="" type="radio"/> Submersible Turbine Jet Flowing Well, Other (Describe) _____		
POWER TYPE (Circle One): <input checked="" type="radio"/> Electric Tractor, Diesel Gasoline, Butane, Other (Describe) _____ H/P 1 1/2		
Pump Capacity (GPM) 22	No. of Stages	Setting Depth 140 FT.
PUMP TEST		
Well yielded _____ GPM with a drawdown of 1 test ft. after _____ hours of pumping		

WELL DATA		
Well Depth 160	Casing Diameter (In.) 4	Casing Length (Ft.) 140
Type of Casing PVC	Hole Depth 160	Depth to Static Water Level 110
TYPE OF COMPLETION: (Circle One or More): <input checked="" type="radio"/> Gravel Packed Underreamed, Telescoped, Natural Development, Open Hole, Other (Describe) _____		
WELL GROUTED TO A DEPTH OF 3 FEET Type Grout (circle one) <input checked="" type="radio"/> Cement, Bentonite, or Mix		

LOG DATA	
TYPE OF LOG RUN (Circle One): Electric, Gamma Ray, Density, <input checked="" type="radio"/> No Log Run, Sonic, Neutron, Other (Describe) _____	
Name of Organization Running Log	

SCREEN DATA		
Diameter - Inches 4	Length - Feet 20	Slot Size - Inches 1013
Screen Type PVC slot	Depth to Bottom - Feet 140	

GEOLOGIC DATA (Office Use Only)			
Surface Elev.	Geologic Unit	Unit Thickness	Depth to Top
Subs. SWL	Date	Analysis	Aquifer Test
Driller's Remarks			
Top of Lap Pipe or Reduction in Casing			
FEET		IF TELESCOPED OR MORE THAN ONE SCREEN: USE BACK PAGE	


DESCRIPTION OF FORMATIONS ENCOUNTERED	FROM	TO
Red + White Clay	0	10
Red Clay	10	70
Red Sand	70	80
Triparted Clay	80	120
White Sand	120	160

FORMATIONS (Continued)	FROM	TO
05-06-98A09:39 RCVD		

IF MORE SPACE IS NEEDED, USE BACK

If well telescopes please
sketch and show depths.

GROUND LEVEL

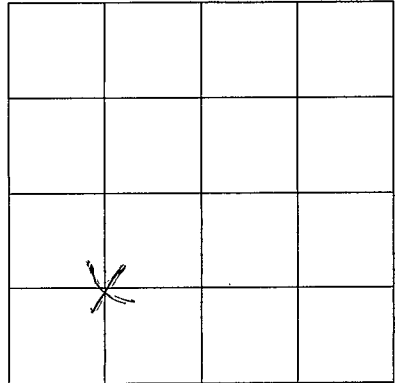

SECTION 35

Please indicate well location X.

ADDITIONAL INFORMATION

If more than one screen,
show location of each on sketch.