

MISSISSIPPI DEPARTMENT OF ENVIRONMENTAL QUALITY

Office of Land and Water Resources

P. O. Box 10631
Jackson, MS 39289-0631
WATER WELL DRILLERS LOG

COUNTY WELL LOCATED PANOLA
WELL NUMBER D 2083
DATE WELL COMPLETED 4-22-99

PERMIT NUMBER HICKS WELL CO.
NAME OF DRILLING FIRM HICKS WELL CO.
LOCATION SENATOCIA, MS 39038

NAME & MAILING ADDRESS OF LANDOWNER MARSHANDA Fonville		
126 Bemis Brunt Rd		
Como, MS 38619		
WELL LOCATION: SEC	TOWNSHIP	RANGE
21	6	5
DISTANCE		DIRECTION
1 Miles		NE
NEAREST TOWN Glennville		
OTHER LANDMARK		
WELL PURPOSE: Home Irrigation, Municipal, Industrial, Fish Pond, etc.		

PUMP DATA		
PUMP TYPE (Circle One): <input checked="" type="radio"/> Submersible, <input type="radio"/> Turbine, <input type="radio"/> Jet <input type="radio"/> Flowing Well, Other (Describe) _____		
POWER TYPE (Circle One): <input checked="" type="radio"/> Electric, <input type="radio"/> Tractor, <input type="radio"/> Diesel, <input type="radio"/> Gasoline <input type="radio"/> Butane, Other (Describe) _____ H/P 3/4		
Pump Capacity (GPM) 12	No. of Stages	Setting Depth 160 FT.
PUMP TEST		
Well yielded no GPM with a drawdown of ft ft. after _____ hours of pumping		

WELL DATA		
Well Depth 222	Casing Diameter (In.) 4	Casing Length (Ft.) 212
Type of Casing PVC	Hole Depth 222	Depth to Static Water Level 140
TYPE OF COMPLETION: (Circle One or More): <input checked="" type="radio"/> Gravel Packed, <input type="radio"/> Underreamed, <input type="radio"/> Telescoped, <input type="radio"/> Natural Development, <input type="radio"/> Open Hole, <input type="radio"/> Other (Describe) _____		
WELL GROUTED TO A DEPTH OF 3 FEET Type Grout (circle one): Cement, <input checked="" type="radio"/> Bentonite or Mix		

LOG DATA	
TYPE OF LOG RUN (Circle One): <input checked="" type="radio"/> No Log Run, <input type="radio"/> Electric, <input type="radio"/> Gamma Ray, <input type="radio"/> Density, <input type="radio"/> Sonic, <input type="radio"/> Neutron, Other (Describe) _____	
Name of Organization Running Log	

SCREEN DATA		
Diameter - Inches 4	Length - Feet 10	Slot Size - Inches .014
Screen Type PVC slot	Depth to Bottom - Feet 212'	


GEOLOGIC DATA (Office Use Only)			
Surface Elev.	Geologic Unit	Unit Thickness	Depth to Top
Subs. SWL	Date	Analysis	Aquifer Test
Driller's Remarks			
Top of Lap Pipe or Reduction in Casing			
FEET		IF TELESCOPED OR MORE THAN ONE SCREEN: USE BACK PAGE	

DESCRIPTION OF FORMATIONS ENCOUNTERED	FROM	TO	FORMATIONS (Continued)	FROM	TO
Red Clay	0	15			
Red Sand + Clay	15	40			
White Sand	40	222			

IF MORE SPACE IS NEEDED, USE BACK

If well telescopes please
sketch and show depths.

GROUND LEVEL

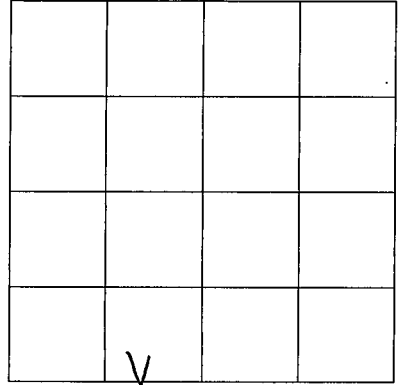

SECTION 21

Please indicate well location X.

ADDITIONAL INFORMATION

If more than one screen,
show location of each on sketch.