

MISSISSIPPI DEPARTMENT OF ENVIRONMENTAL QUALITY

Office of Land and Water Resources

P. O. Box 10631
Jackson, MS 39289-0631
WATER WELL DRILLERS LOG

COUNTY WELL LOCATED PANOLA	
WELL NUMBER D-2088	CODED
DATE WELL COMPLETED 6-30-00	

PERMIT NUMBER
NAME OF DRILLING FIRM HICKS WELL CO.

NAME & MAILING ADDRESS OF LANDOWNER John Varadi			
424 Blue Room Rd			
Como, MS 38619			
WELL LOCATION	SEC	TOWNSHIP	RANGE
	31	6	5
		N	E
DISTANCE	DIRECTION	NEAREST TOWN	
1 3/4	SW	of Glenville	
OTHER LANDMARK			
WELL PURPOSE <u>Home</u> , Irrigation, Municipal, Industrial, <u>Fish Pond</u> , etc.			

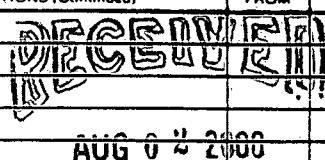
PUMP DATA		
PUMP TYPE (Circle One): <u>Submersible</u> Turbine, Jet, Flowing Well, Other (Describe)		
POWER TYPE (Circle One): <u>Electric</u> Tractor, Diesel, Gasoline, <u>3/4</u> Butane, Other (Describe) <u>H/P</u> <u>3/4</u>		
Pump Capacity (GPM) 10	No of Stages	Setting Depth 140 FT.
PUMP TEST		
Well yielded <u>no</u> GPM with a drawdown of <u>Test</u> ft. after _____ hours of pumping		

WELL DATA		
Well Depth 203	Casing Diameter (In.) 4	Casing Length (Ft.) 193
Type of Casing PVC	Hole Depth 203	Depth to Static Water Level 110
TYPE OF COMPLETION (Circle One or More): <u>Gravel Packed</u> , Underreamed, Telescoped, Natural Development, Open Hole, Other (Describe)		
WELL GROUTED TO A DEPTH OF 3 FEET Type Grout (circle one): Cement, <u>Bentonite</u> , or Mix		

LOG DATA	
TYPE OF LOG RUN (Circle One): Electric, Gamma Ray, Density, <u>Sonic</u> , Neutron, Other (Describe)	
Name of Organization Running Log	

SCREEN DATA		
Diameter - Inches 4	Length - Feet 10	Slot Size - Inches 1013
Screen Type PVC Slotted	Depth to Bottom - Feet 193	

GEOLOGIC DATA (Office Use Only)			
Surface Elev	Geologic Unit	Unit Thickness	Depth to Top
Subs SWL	Date	Analysis	Aquifer Test
Driller's Remarks			
Top of Lap Pipe or Reduction in Casing			
FEET		IF TELESCOPED OR MORE THAN ONE SCREEN: USE BACK PAGE	

DESCRIPTION OF FORMATIONS ENCOUNTERED	FROM	TO	FORMATIONS (Continued)	FROM	TO
Red + White Sand	0	59			
Rock	59	58			
White Sand + Clay	58	158			
White Sand	150	223			
			Dept. of Environmental Quality Office of Land & Water Resources		
IF MORE SPACE IS NEEDED, USE BACK					

