

WATER WELL DRILLERS LOG

E
8-20-63

Date: 8-20, 1963, Driller: J B CAIN County: Panola

(Name)

(1) Owner of Land	Description & Color of Materials Sand, Clay, Red Clay, Shell, etc.	Thick- ness Feet	Depth Feet
Robert Haddage (Name) Crenshaw miss (Address)	Sand	0	60
(2) Location: 1/4, 1/4, Sec. T R			
1 miles south of Crenshaw (distance) (direction) (Nearest Town)			
(3) Topography: <input checked="" type="checkbox"/> (Level)			
(4) Purpose of Well: Stock (Domestic Irrigation Municipal, Industrial, Other)			

Information upon completion of well:

(1) Diameter 2 inches.

(2) Total Depth 60 feet.

(3) Water Level 12 feet below top of ground.

(4) Cased to 60, Size 2"


(5) Screen: Size 3" Length 5
Plastic well + screen

(6) Were any formations sealed against pollution?
_____ yes, _____ no.

If YES depth of formation _____

Why _____

Drillers Remarks: _____

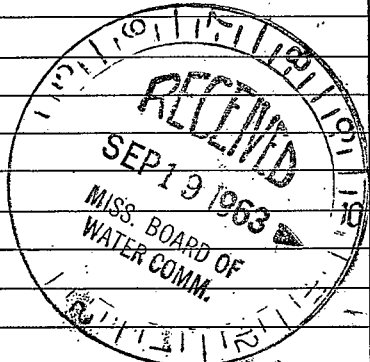

(Use Back Side)

Well No.

