

PANOLA  
E 6  
1-9-63

MISSISSIPPI BOARD OF WATER COMMISSIONERS

WATER WELL DRILLERS LOG

CODED

Date: 1-9, 1963, Driller: James R. Lipe County Panola  
(Name)


(1) Owner of Land:	Description & Color of Materials Sand, Clay, Red Clay, Shell, etc.	Thick- ness Feet	Depth Feet
<u>Hoby Short</u> (Name) <u>Sardis, Miss.</u> (Address)	<u>Clay</u>	<u>0</u>	<u>15</u>
(2) Location: _____ 1/4, _____ 1/4, Sec. <u>22</u> T <u>7</u> R <u>W</u>	<u>Clay &amp; gravel</u>	<u>15</u>	<u>30</u>
<u>8</u> miles <u>N.W.</u> , of <u>Sardis</u> (distance) (direction) (Nearest Town)	<u>Sand &amp; gravel</u>	<u>40</u>	<u>65</u>
(3) Topography: _____ (Hilly) (Flat) (Level)	<u>Blue Clay</u>	<u>65</u>	<u>105</u>
(4) Purpose of Well: _____ (Domestic Irrigation Municipal, Industrial, Other)	<u>W/leaving sand</u>	<u>105</u>	<u>156</u>

Information upon completion of well:

- (1) Diameter 2 1/2 inches.
- (2) Total Depth 156 feet.
- (3) Water Level 90 feet below top of ground.
- (4) Cased to 149, Size 2 1/2"
- (5) Screen: Size 2 1/4, Length 6'
- (6) Were any formations sealed against pollution?  
\_\_\_\_\_ yes, \_\_\_\_\_ no.

If YES depth of formation \_\_\_\_\_  
Why \_\_\_\_\_

Drillers Remarks: \_\_\_\_\_  
\_\_\_\_\_  
\_\_\_\_\_

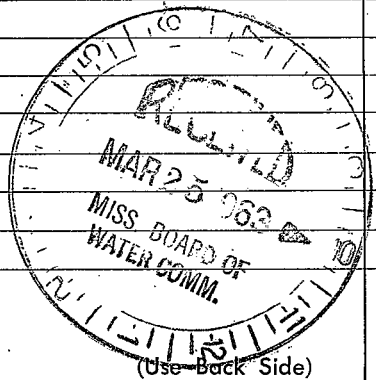

(Use Back Side)

Well No.

