

Panola
E 7
12-68

MISSISSIPPI
BOARD OF WATER COMMISSIONERS
416 North State Street
Jackson, Mississippi 39201

CODED

WATER WELL DRILLERS LOG

James R. Iipe Panola

19 date well completed firm name county well located

LANDOWNER: Mrs. Gee
Pleasant Grove
Miss.
(mailing address)

WELL LOCATION:
sec. 25 T. 7 N R. 9 E
2 miles west of Pleasant Grove
(distance) (direction) (nearest town)


description of formations encountered	from	to
Clay	0	20
Clay and sand	20	40
Gravel	40	60
Gravel	60	75
Clay	75	80
Clay	80	100
Clay	100	120
Clay	120	140
Clay and sand	140	160
Clay	160	180
Clay and sand	180	200
Water sand	200	220

WELL PURPOSE: home
(home, irrigation, municipal, industrial)

WELL COMPLETION DATA:


- (1) diameter (inches) 4"
- (2) total depth (feet) 220
- (3) static water level (feet) 120 (below above top of ground)
- (4) casing Plastic, 205 (material) (depth)
If telescope see back.
- (5) screen 15" 205 (length) (depth to top)
4" Plastic (size) (material)
- (6) pump 3/4 10 (HP) (yield gpm)
Electric (type power)
- (7) electric log no (yes or no)
(organization running log)
- (8) how well bottom plugged Plastic Plug

DRILLERS REMARKS:

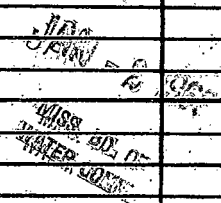

If well telescopes please sketch and show depths.

GROUND LEVEL

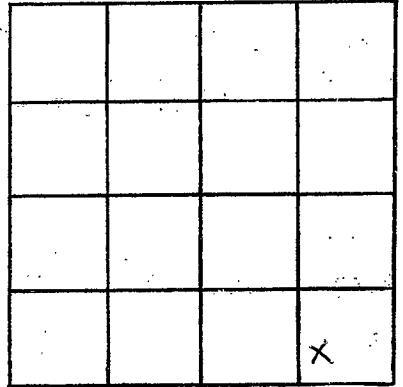

SECTION 26

Please indicate well location X.

ADDITIONAL INFORMATION

If more than one screen,
show locations of each on sketch.