

Panola
E 8
8-23-73

MISSISSIPPI
BOARD OF WATER COMMISSIONERS
416 North State Street
Jackson, Mississippi 39201

CODED

WATER WELL DRILLERS LOG

8-23 1973 James R. Lipe Panola
date well completed firm name county well located

LANDOWNER:
THOMAS COPOUS
COMO Miss.
(mailing address)

WELL LOCATION:
sec. 9 T 7 N R 9 E
10 miles west of Como
(distance) (direction) (nearest town)

WELL PURPOSE:
(home) irrigation, municipal, industrial

- WELL COMPLETION DATA:
- (1) diameter (inches) 4
 - (2) total depth (feet) 251
 - (3) static water level (feet) 130 below top of ground.
 - (4) casing PVC, 239,
(material) (depth)
4 if telescope see back.
(size)
 - (5) screen 12, 239
(length) (depth to top)
4, PVC
(size) (material)
 - (6) pump 3/4, 12
(HP) (yield gpm)
elec.
(type power)
 - (7) electric log no
(yes or no)
no
(organization running log)
 - (8) how well bottom plugged PVC
plug

description of formations encountered	from	to
TOP soil	0	20
CLAY	20	40
CLAY	40	60
red sand	60	80
CLAY and sand	80	100
CLAY	100	120
CLAY	120	140
Blue clay	140	160
CLAY	160	180
CLAY	180	200
sand and clay	200	220
Good sand	220	240
CLAY	240	251

CODED


DRILLERS REMARKS:

SEP 6 1973

MISSISSIPPI
WATER BOARD

if well telescopes please
sketch and show depths.

GROUND LEVEL

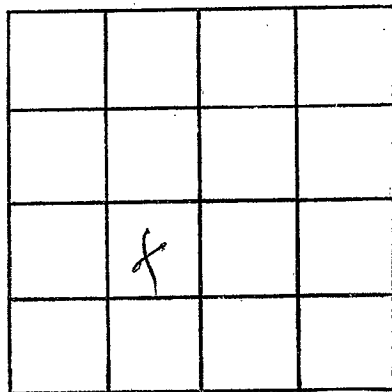

SECTION 9

Please indicate well location X.

ADDITIONAL INFORMATION

If more than one screen,
show locations of each on sketch.