

PANOLA
E 10
3-6-71

MISSISSIPPI
BOARD OF WATER COMMISSIONERS
416 North State Street
Jackson, Mississippi 39201

CODED

WATER WELL DRILLERS LOG

March 6 1971 J. B. Cain PANOLA
date well completed firm name county well located

LANDOWNER: Rex Curtis

description of formations encountered

from to

Cheshaw, Miss.
(mailing address)

RED CLAY	0	30
GRAVEL	30	80
BLUE CLAY	80	150
WATER SAND	150	210

WELL LOCATION:

sec. 16 T 7 N R 9 E W
miles of (distance) (direction) (nearest town)

WELL PURPOSE: Home
(home, irrigation, municipal, industrial)

WELL COMPLETION DATA:

- (1) diameter (inches) 4"
(2) total depth (feet) 210'
(3) static water level (feet) 138 below top of ground.
(4) casing Plastic, 900' (material) (depth)
4" (size) if telescope see back.
(5) screen 10' (length) (depth to top)
3" Plastic (size) (material)
(6) pump 3/4 (HP) (yield gpm)
220 (type power)
(7) electric log NO (yes or no)

(organization running log)

(8) how well bottom plugged SHARK WASH BOT.

CODED


APR - 6 1971

DRILLERS REMARKS:

MISS. BD. OF
WATER COMMISSIONERS

If well telescopes please sketch and show depths.

GROUND LEVEL

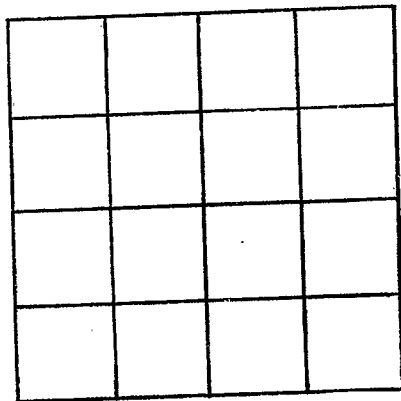

SECTION _____

Please indicate well location X.

ADDITIONAL INFORMATION

If more than one screen, show locations of each on sketch.