

Panola  
E 515  
3-31-69

MISSISSIPPI  
 BOARD OF WATER COMMISSIONERS  
 416 North State Street  
 Jackson, Mississippi 39201

WATER WELL DRILLERS LOG


Mar 31 1969 Poterson Well Drilling Co Panola  
 date well completed firm name county well located

LANDOWNER: <u>M.R. Wilson</u>	description of formations encountered	from	to
<u>Sardis, Miss</u> (mailing address)	<u>Red Clay</u>	<u>0</u>	<u>20</u>
WELL LOCATION: sec. <u>1</u> T. <u>19</u> N. R. <u>9</u> E <u>14</u> miles <u>W</u> of <u>Sardis</u> (distance) (direction) (nearest town)	<u>Red Clay + gravel</u>	<u>20</u>	<u>40</u>
WELL PURPOSE: <u>Home</u> (home, irrigation, municipal, industrial)	<u>sand + gravel</u>	<u>40</u>	<u>80</u>
WELL COMPLETION DATA: (1) diameter (inches) <u>4"</u>	<u>sand</u>	<u>80</u>	<u>90</u>
(2) total depth (feet) <u>90</u>			
(3) static water level (feet) <u>45</u> below top of ground.			
(4) casing <u>plastic</u> <u>85</u> (material) (depth) <u>4"</u> (size) If telescope see back.			
(5) screen <u>5 ft</u> <u>85</u> (length) (depth to top) <u>4"</u> <u>gravel packed</u> (size) (material)			
(6) pump <u>1/2</u> <u>18</u> (HP) (yield gpm) <u>220</u> (type power)			
(7) electric log <u>no</u> (yes or no)  (organization running log)			
(8) how well bottom plugged <u>Capped</u>			
DRILLERS REMARKS: <u>Plastic</u> <u>Water Well</u>			

MAY 23 1969  
 MISS. Bd. OF  
 WATER COMMISSIONERS

If well telescopes please sketch and show depths.

GROUND LEVEL

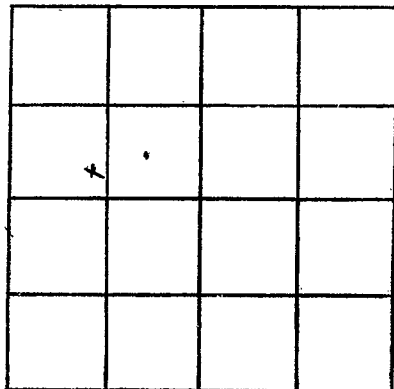

SECTION 1

Please indicate well location X.

ADDITIONAL INFORMATION

If more than one screen,  
show locations of each on sketch.