

PANOLA  
E 18  
4-20-72

MISSISSIPPI  
BOARD OF WATER COMMISSIONERS  
416 North State Street  
Jackson, Mississippi 39201

**CODED**

WATER WELL DRILLERS LOG

APRIL 20 1972 W. A. B. Co. Panola  
date well completed firm name county well located

LANDOWNER: MR SPEARS  
  
(mailing address)  
  
WELL LOCATION:  
sec. 23 T 7 N R 9 E  
3 miles S-E of Pleasant  
(distance) (direction) (nearest town)

description of formations encountered	from	to
<u>CLAY</u>	<u>0</u>	<u>40</u>
<u>Gravel</u>	<u>40</u>	<u>100</u>
<u>Brown Clay</u>	<u>100</u>	<u>180</u>
<u>Blue CLAY</u>	<u>180</u>	<u>220</u>
<u>Sand</u>	<u>220</u>	<u>260</u>

WELL PURPOSE:  
(home, irrigation, municipal, industrial)

WELL COMPLETION DATA:  
 (1) diameter (inches) 4"  
 (2) total depth (feet) 260  
 (3) static water level (feet) 114 below top of ground.  
 (4) casing PLASTIC, 260,  
 (material) (depth)  
 \_\_\_\_\_ if telescope see back.  
 (size)  
 (5) screen 10' 250  
 (length) (depth to top)  
4" PLASTIC  
 (size) (material)  
 (6) pump 3/4 10  
 (HP) (yield gpm)  
Elec  
 (type power)  
 (7) electric log No  
 (yes or no)  
 \_\_\_\_\_  
 (organization running log)  
 (8) how well bottom plugged plug

**CODED**


APR 17 1972

DRILLERS REMARKS:

MIS:  
WATER:

If well telescopes please sketch and show depths.

GROUND LEVEL

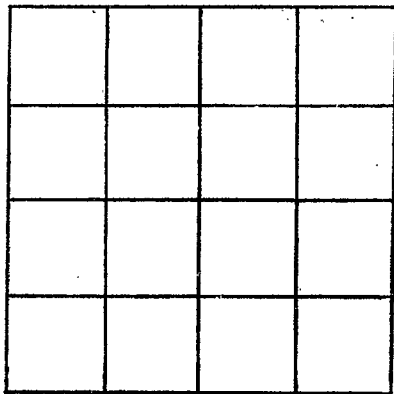

SECTION \_\_\_\_\_

Please indicate well location X.

ADDITIONAL INFORMATION

If more than one screen, show locations of each on sketch.