

**PANOLA**  
**E 20**  
**7-25-72**

MISSISSIPPI  
 BOARD OF WATER COMMISSIONERS  
 416 North State Street  
 Jackson, Mississippi 39201

**CODED**

WATER WELL DRILLERS LOG

7-25-1972 Hicks Bros. Well Co. Panola  
 date well completed firm name county well located

LANDOWNER: <u>Bob Payne</u>	description of formations encountered	from	to
<u>Long Town</u>			
(mailing address)	<u>Red Clay</u>	<u>0</u>	<u>45</u>
WELL LOCATION: sec. <u>16</u> T. <u>7</u> N. R. <u>9</u> E. <u>10</u> miles <u>NW</u> of <u>COMO</u> (distance) (direction) (nearest town)	<u>Red Clay &amp; Red Sand</u>	<u>45</u>	<u>60</u>
WELL PURPOSE: <u>HOME</u> (home, irrigation, municipal, industrial)	<u>Red Sand</u>	<u>60</u>	<u>90</u>
WELL COMPLETION DATA: (1) diameter (inches) <u>4 inches</u>	<u>Red Sand &amp; Red Loeb</u>	<u>90</u>	<u>105</u>
(2) total depth (feet) <u>270</u>	<del>Red Sand</del> <u>Red Sand</u>	<u>105</u>	<u>120</u>
(3) static water level (feet) <u>160</u> below top of ground.	<u>White Clay</u>	<u>120</u>	<u>185</u>
(4) casing <u>Plastic</u> (material) <u>270</u> (depth)	<u>Black Clay</u>	<u>185</u>	<u>225</u>
(size) if telescope see back.	<u>Black Clay &amp; Sand</u>	<u>225</u>	<u>255</u>
(5) screen <u>10 ft.</u> (length) <u>260 ft.</u> (depth to top)	<u>White Sand</u>	<u>255</u>	<u>270</u>
<u>4 in.</u> (size) <u>Slotted</u> (material)			
(6) pump <u>3/4</u> (HP) <u>108 GPM</u> (yield gpm)			
(type power)			
(7) electric log <u>No</u> (yes or no)			
(organization running log)			
(8) how well bottom plugged <u>Cap</u>			
DRILLERS REMARKS:			


**CODED**

AUG 18 1972

MISS. BD. OF  
 WATER CONTROL

If well telescopes please sketch and show depths.

GROUND LEVEL

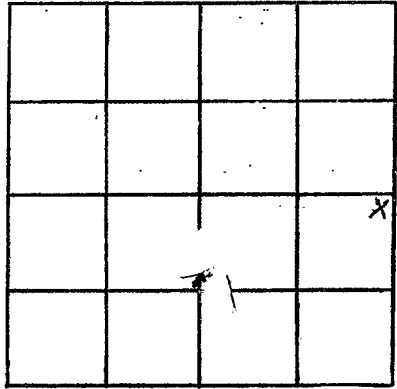

SECTION Q16

Please indicate well location X.

ADDITIONAL INFORMATION

A series of horizontal lines for writing additional information.

If more than one screen, show locations of each on sketch.